


THE PROCUREMENT OF WAREHOUSE EPOXY FLOOR WORK

NEGELLE BORENA ,ETHIOPIAN

UNOPS - ETMCO

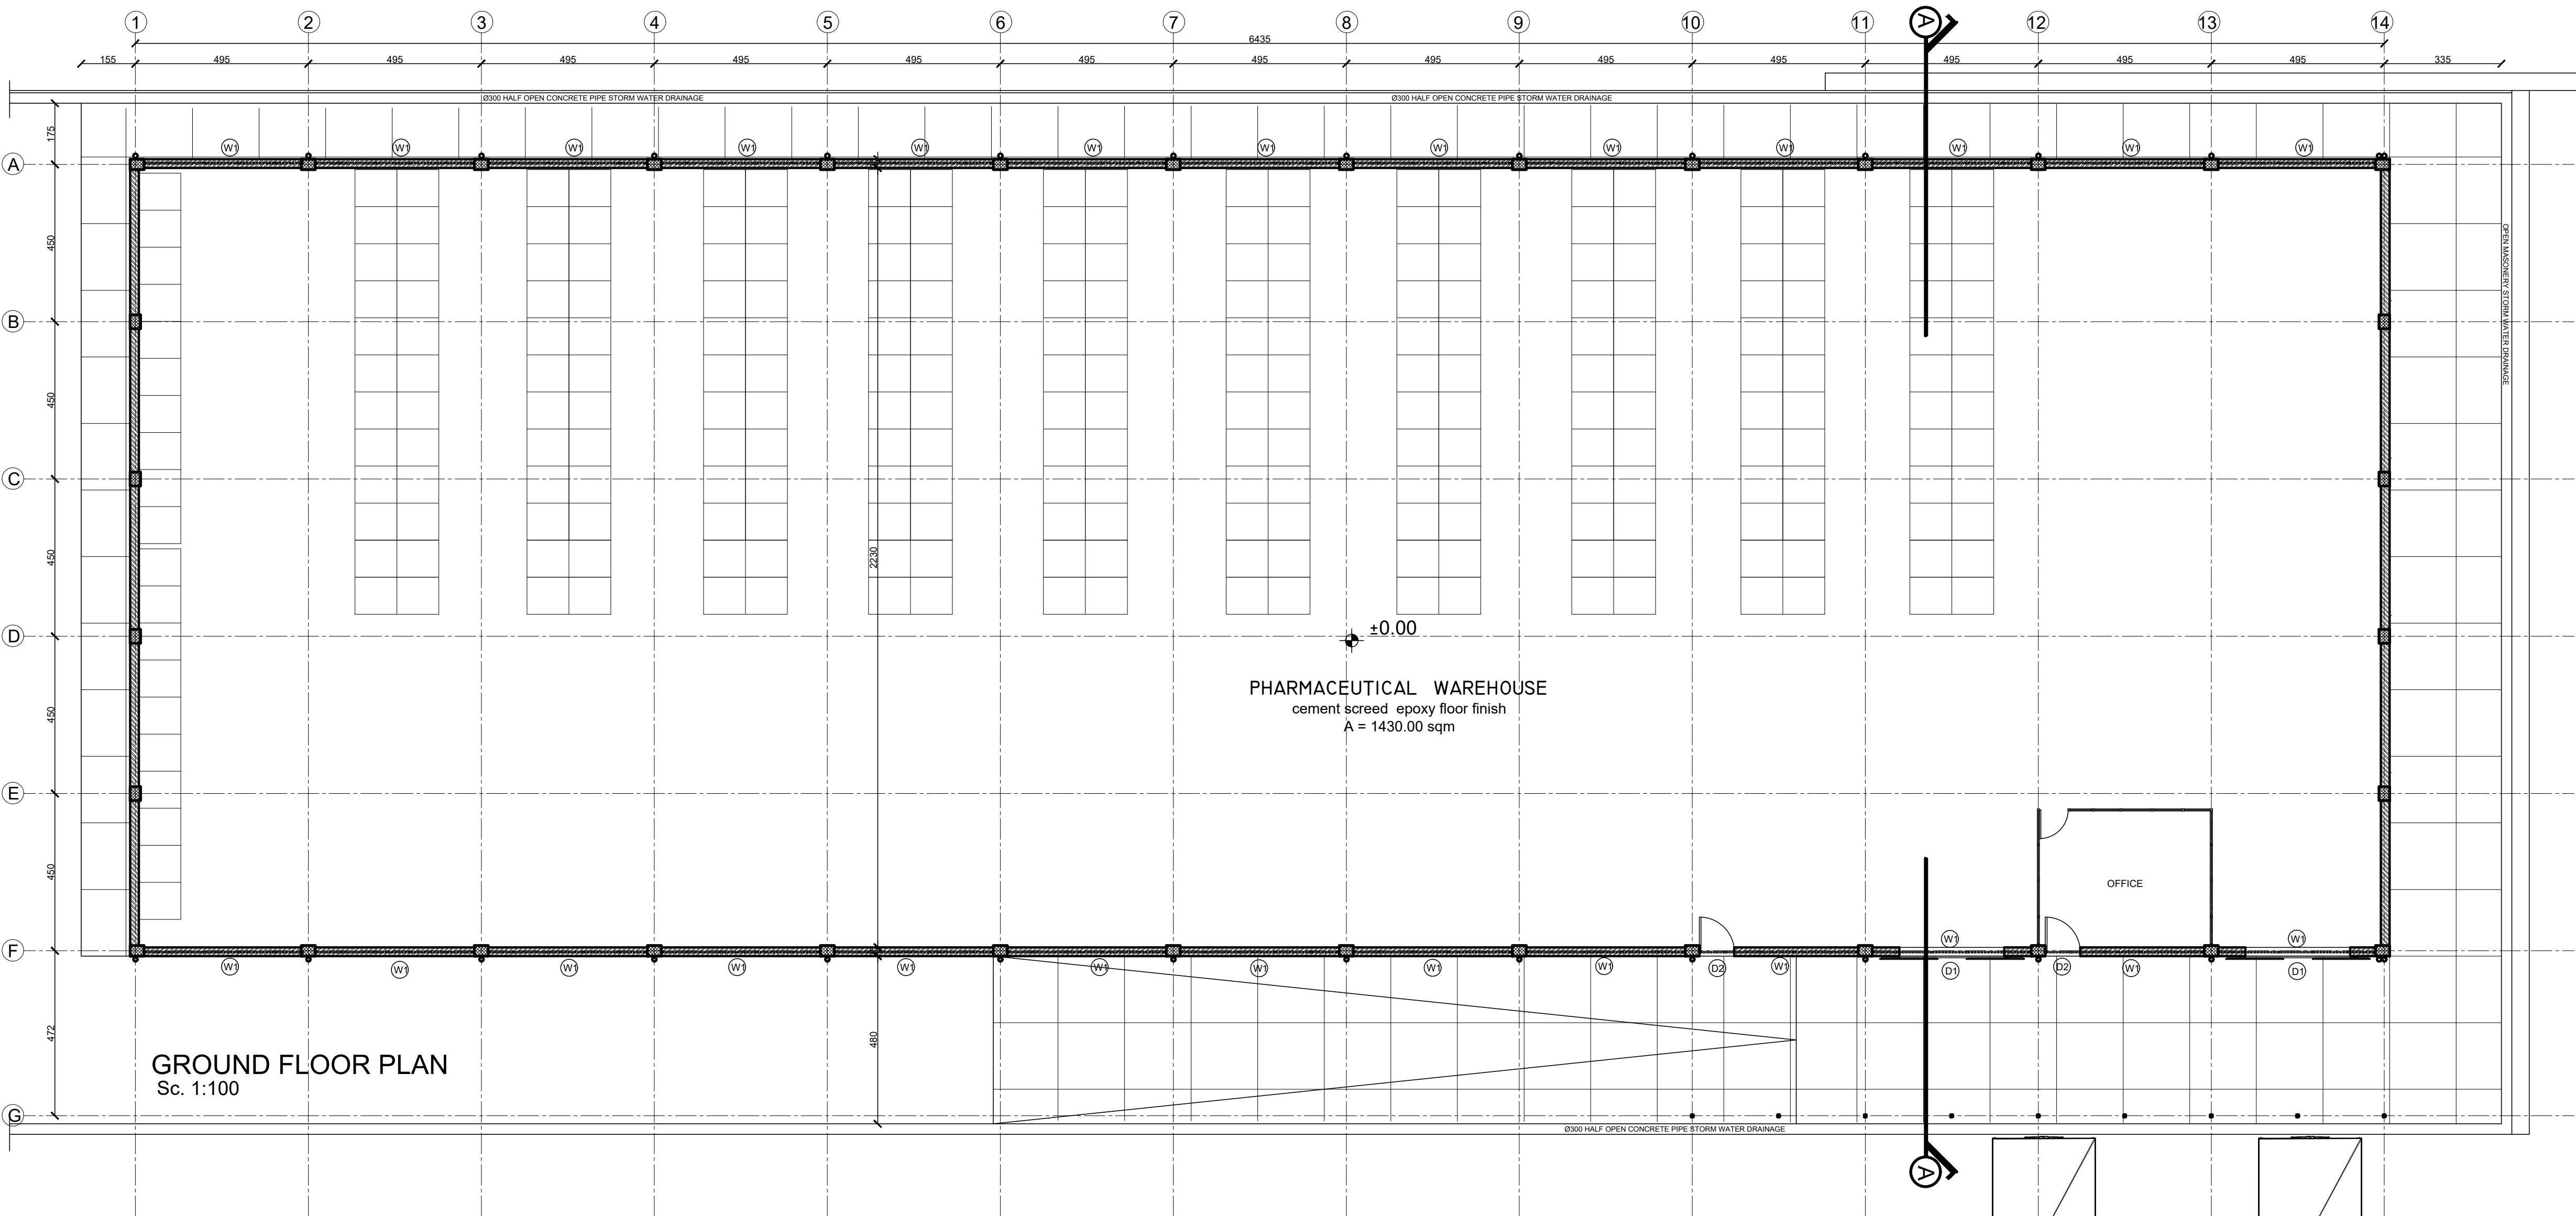

GROUND FLOOR PLAN
Sc. 1:100

GENERAL NOTES:

Note:

- 1) Roofing:-
 - Replace damaged roof sheets and gutter.
 - Fix loose connections and joints.
 - Ensure no water leakage via roofing system.
 - Replace damaged down pipe and ensure proper connection vertically and with drainage line.
 - Replaced damaged heat insulation and use standard support wire underneath the roof sheets.
- 2) Interior & Exterior Walls:-
 - Patch and repair defective plaster & repaint internal wall.
 - Patch and repair defective plaster & quartzes paint external wall.
- 3) Floor Finish:-
 - Patch & repair construction joint and cement screed flooring.
 - Apply approved self leveling and epoxy floor coating above cement screed flooring.
 - Apply paint/skirting for HCB wall and concrete column.
 - Apply warehouse safety line/traffic painting on epoxy flooring.
 - Provide PWD access to the warehouse.


	/	/		
	/	/		
0	/	/		
Rev.:	Date:	Description:	Approved	

KEY PLAN

All information in this document is the property of UNOPS and cannot be copied anywhere but in this project without prior written consent of UNOPS.	
Funded By:	Partner:
	ETHIOPIAN PHARMACEUTICAL SUPPLY SERVICE (EPSS)
Program:	Implemented By:
THE PROCUREMENT OF WAREHOUSE FLOOR EPOXY WORK	UNOPS - ETMCO
Project Name:	Design:
WAREHOUSE FLOOR EPOXY WORK NEGELLE BORENA	UNOPS-ETMCO
Drawing Title:	

GROUND FLOOR PLAN

Designed by			Discipline:	Dr. No:	Tot. No:	Rev No:
			AR	01	04	As built
Drawn:	Checked:	Approved:	Size:	Scale:	Date:	Rev.:
FM	AE	SH	A1	1:100	6 / 25 / 2024	0

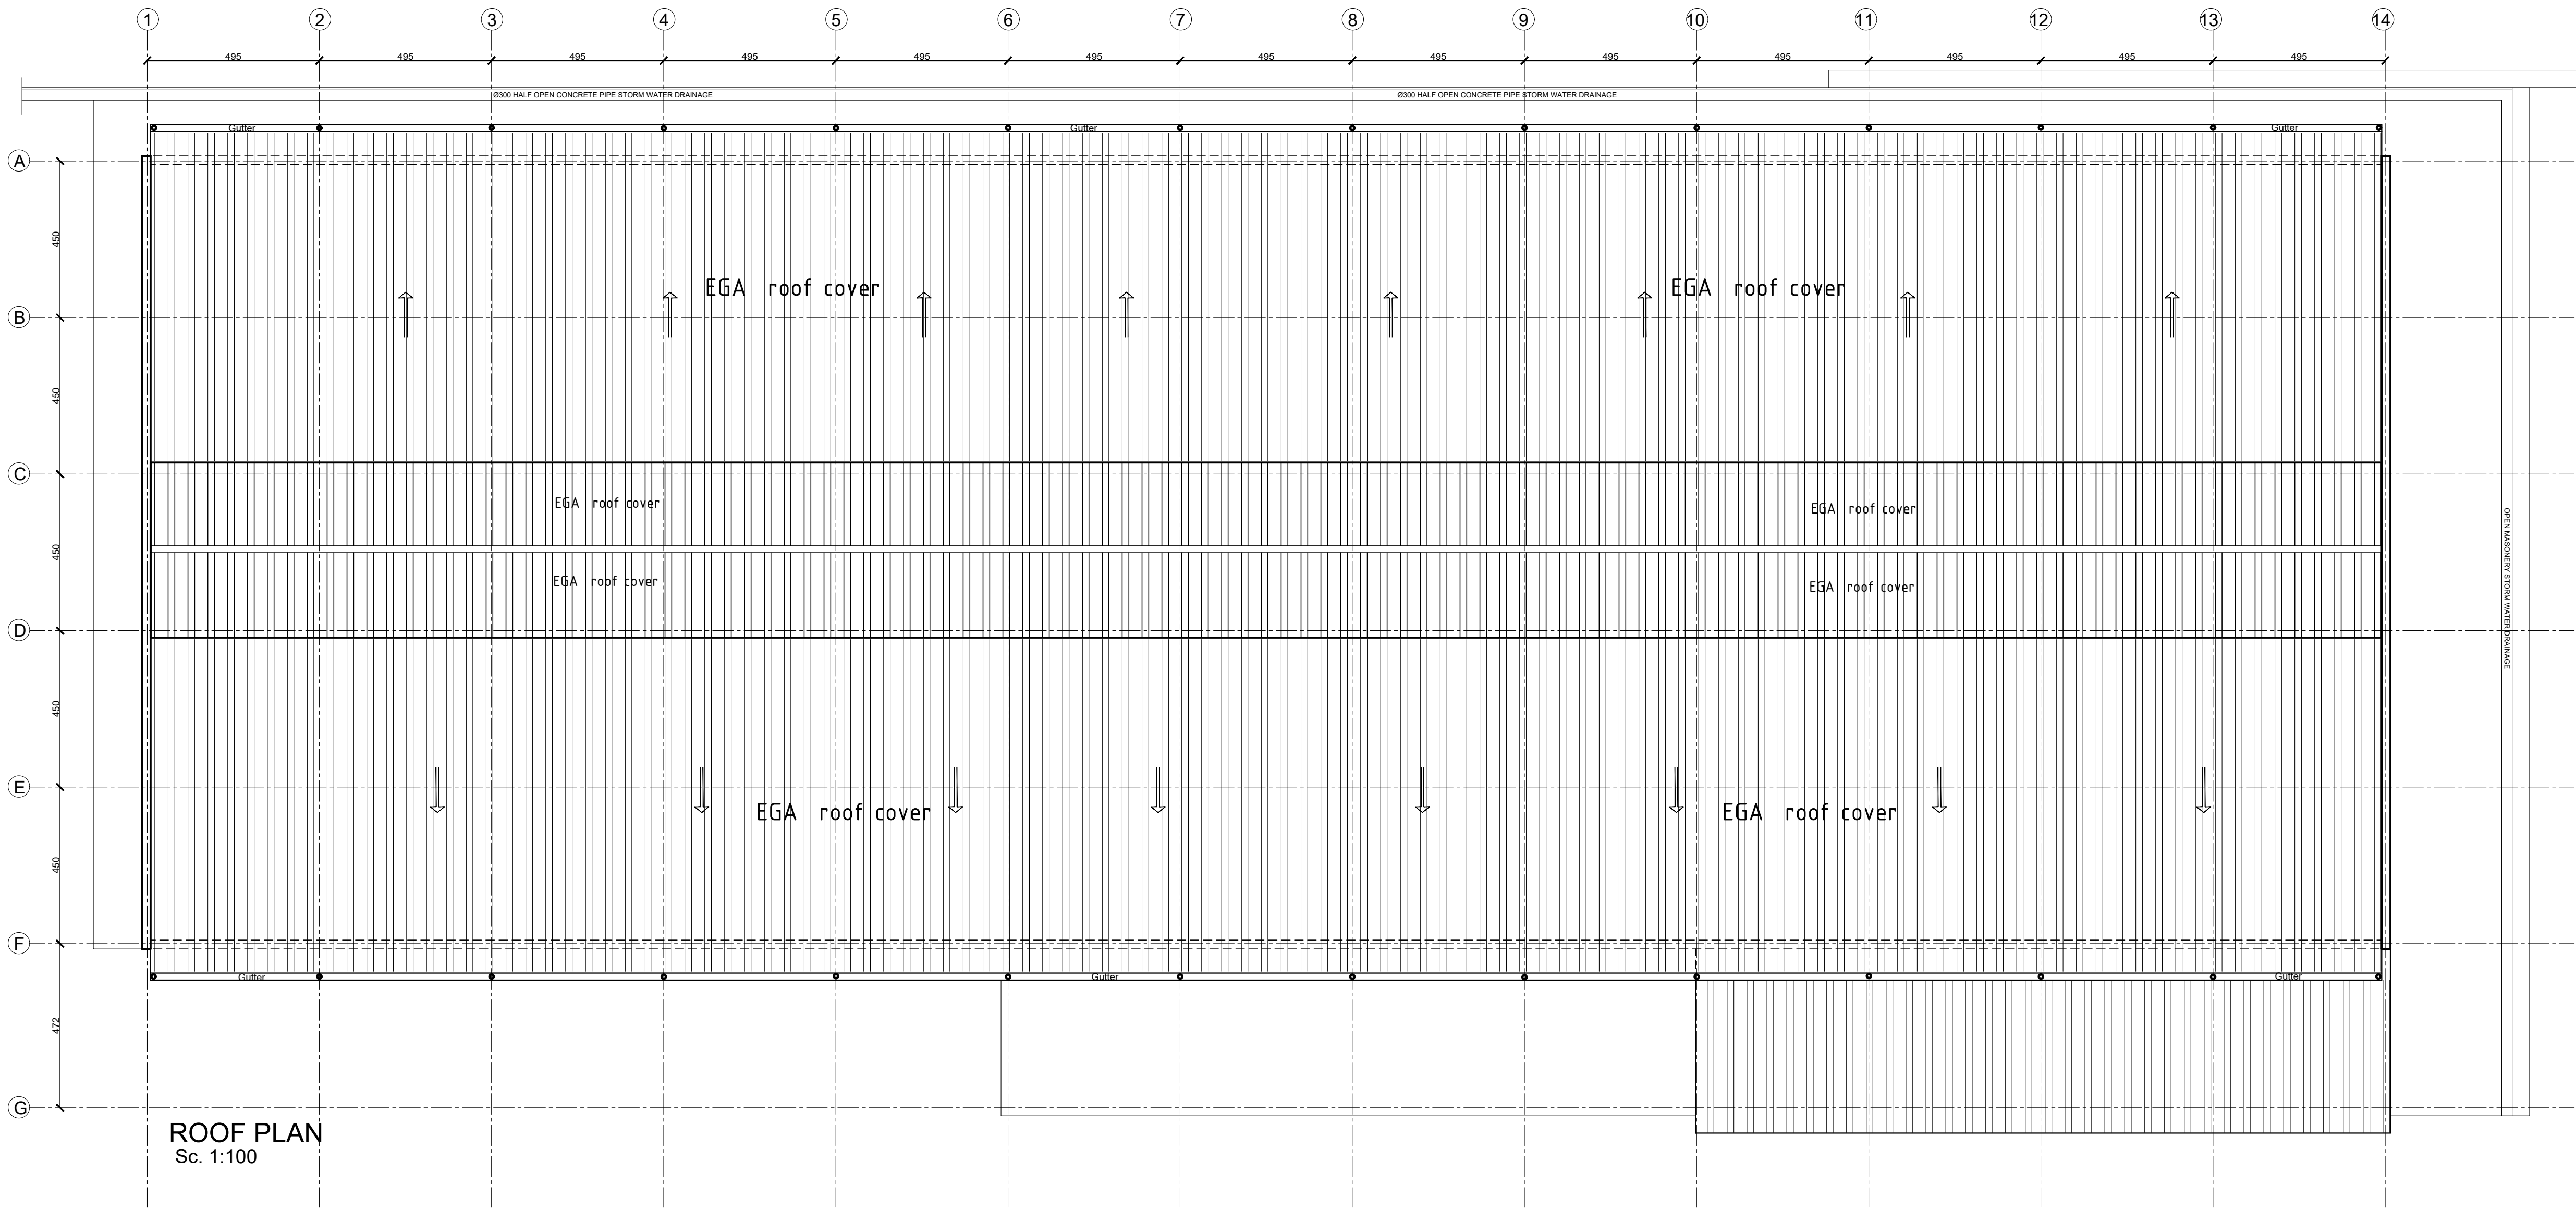


- GENERAL NOTES:
- Note:
- 1) Roofing:-
- Replace damaged roof sheets and gutter.
 - Fix loose connections and joints.
 - Ensure no water leakage via roofing system.
 - Replace damaged down pipe and ensure proper connection vertically and with drainage line.
 - Replaced damaged heat insulation and use standard support wire underneath the roof sheets.
- 2) Interior & Exterior Walls:-
- Patch and repair defective plaster & repaint internal wall.
 - Patch and repair defective plaster & quartzes paint external wall.
- 3) Floor Finish:-
- Patch & repair construction joint and cement screed flooring.
 - Apply approved self leveling and epoxy floor coating above cement screed flooring.
 - Apply paint/skirting for HCB wall and concrete column.
 - Apply warehouse safety line/traffic painting on epoxy flooring.
 - Provide PWD access to the warehouse.

	/	/		
	/	/		
0	/	/		
Rev.:	Date:	Description:	Approved	

KEY PLAN

All information in this document is the property of UNOPS and cannot be copied anywhere but in this project without prior written consent of UNOPS.

Funded By:	Partner:					
	ETHIOPIAN PHARMACEUTICAL SUPPLY SERVICE (EPSS)					
Program:	Implemented By:					
THE PROCUREMENT OF WAREHOUSE FLOOR EPOXY WORK	UNOPS - ETMCO					
Project Name:	Design:					
WAREHOUSE FLOOR EPOXY WORK NEGELLE BORENA	UNOPS-ETMCO					
Drawing Title:						
ROOF PLAN						
Designed by	Discipline:	Dr. No:	Tot. No:	Rev No:		
	AR	02	04	As built		
Drawn:	Checked:	Approved:	Size:	Scale:	Date:	Rev.:
FM	AE	SH	A1	1:100	6 / 25 / 2024	0

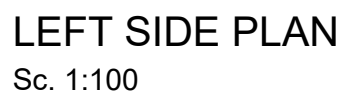


- Patch & repair construction joint and cement screed flooring.
- Apply approved self leveling and epoxy floor coating above cement screed flooring.
- Apply paint/skirting for HCB wall and concrete column.
- Apply warehouse safety line/traffic painting on epoxy flooring.
- Provide PWD access to the warehouse.

Rev.:	Date:	Description:	Approved
-------	-------	--------------	----------


All information in this document is the property of UNOPS and cannot be copied anywhere but in this project without prior written consent of UNOPS.

<p>Funded By:</p>	<p>Partner:</p>
<p>Program:</p>	<p>ETHIOPIAN PHARMACEUTICAL SUPPLY SERVICE (EPSS)</p>
<p>THE PROCUREMENT OF WAREHOUSE FLOOR EPOXY WORK</p>	<p>UNOPS - ETMCO</p>
<p>Project Name:</p>	<p>Design:</p>
<p>WAREHOUSE FLOOR EPOXY WORK NEGELLE BORENA</p>	<p>UNOPS-ETMCO</p>

Designed by			Discipline:	Dr. No:	Tot. No:	Rev. No:		
			AR	03	04	As bui		
Drawn:	Checked:	Approved:	Size:	Scale:	Date:	Rev.:		
FM	AE	SH	A1	1:100	6 / 25 / 2024	0		

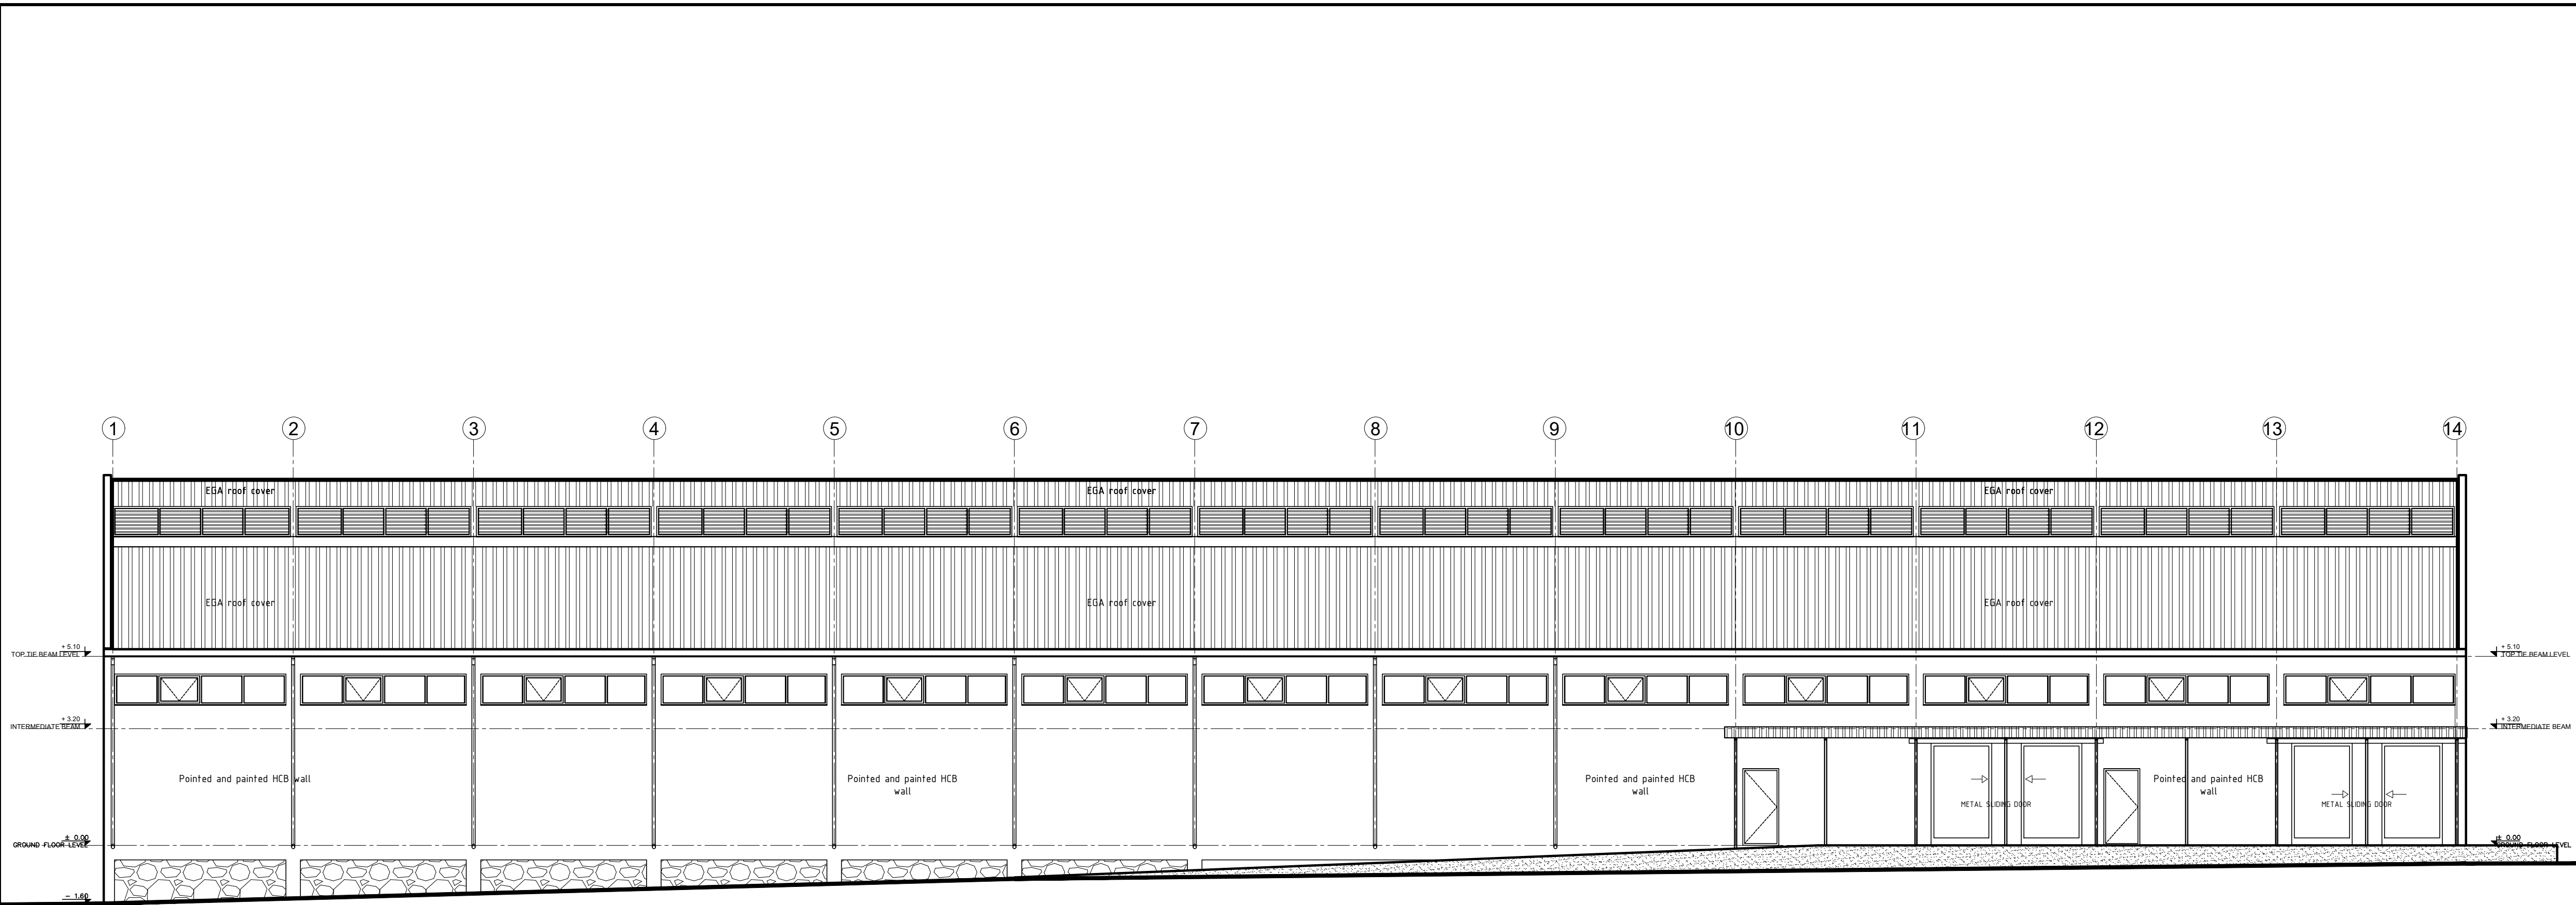

FRONT ELEVATION
Sc. 1:100

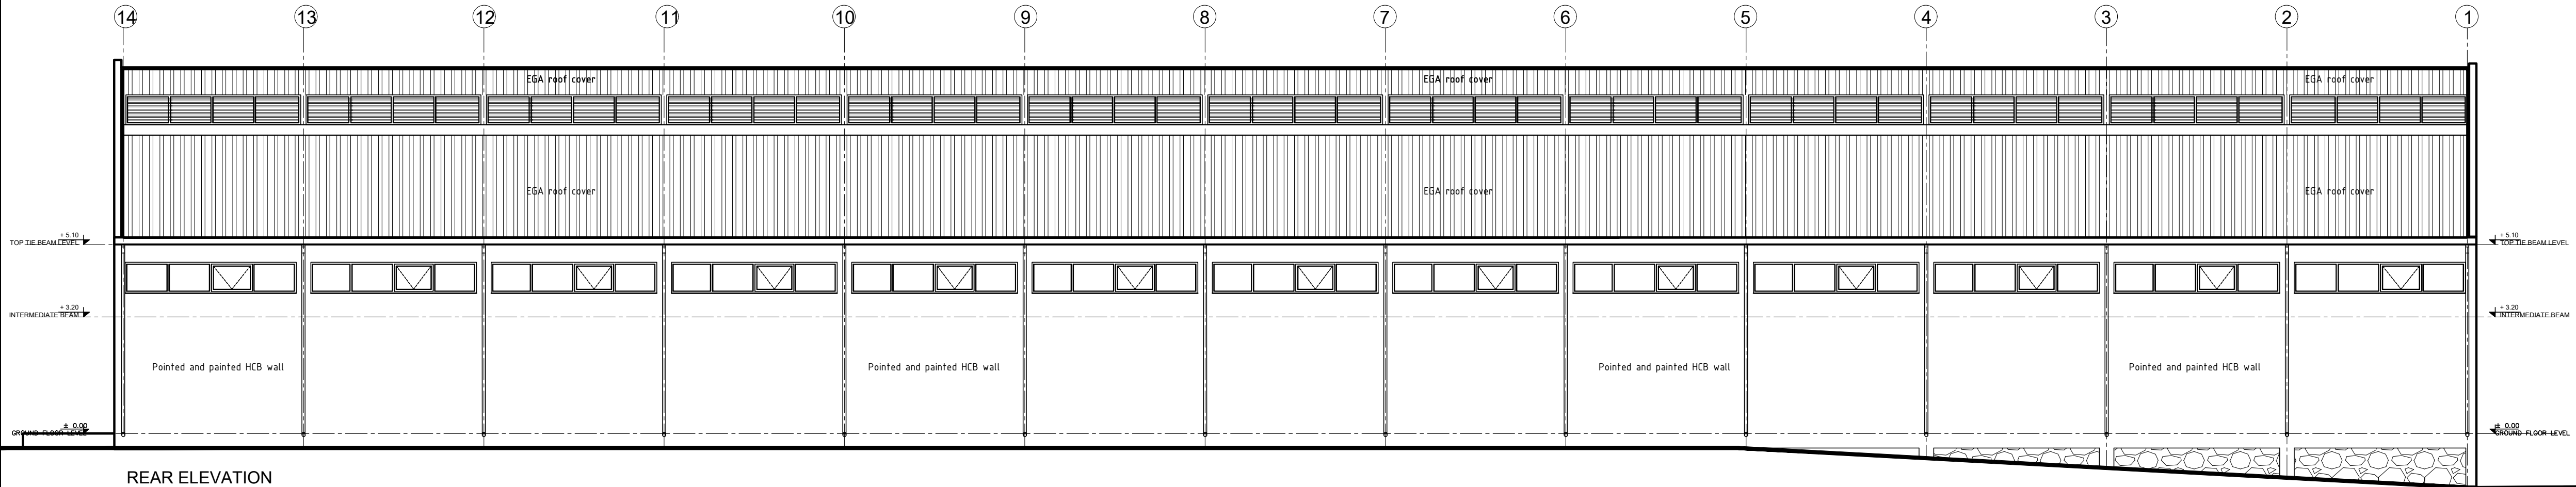

REAR ELEVATION
Sc. 1:100

- GENERAL NOTES:
- Note:
- 1) Roofing:-
- Replace damaged roof sheets and gutter.
 - Fix loose connections and joints.
 - Ensure no water leakage via roofing system.
 - Replace damaged down pipe and ensure proper connection vertically and with drainage line.
 - Replaced damaged heat insulation and use standard support wire underneath the roof sheets.
- 2) Interior & Exterior Walls:-
- Patch and repair defective plaster & repaint internal wall.
 - Patch and repair defective plaster & quartzes paint external wall.
- 3) Floor Finish:-
- Patch & repair construction joint and cement screed flooring.
 - Apply approved self leveling and epoxy floor coating above cement screed flooring.
 - Apply paint/skirting for HCB wall and concrete column.
 - Apply warehouse safety line/traffic painting on epoxy flooring.
 - Provide PWD access to the warehouse.

	/	/		
	/	/		
0	/	/		

Rev.: Date: Description: Approved

KEY PLAN

All information in this document is the property of UNOPS and cannot be copied anywhere but in this project without prior written consent of UNOPS.

Funded By:	Partner:
	ETHIOPIAN PHARMACEUTICAL SUPPLY SERVICE (EPSS)
Program:	Implemented By:
THE PROCUREMENT OF WAREHOUSE FLOOR EPOXY WORK	UNOPS - ETMCO
Project Name:	Design:
WAREHOUSE FLOOR EPOXY WORK NEGELLE BORENA	UNOPS-ETMCO
Drawing Title:	

ELEVATION				
Designed by	Discipline:	Dr. No:	Tot. No:	Rev No:
	AR	04	04	As built
Drawn:	Checked:	Approved:	Size:	Scale:
FM	AE	SH	A1	1:100
			Date:	Rev.:
			6 / 25 / 2024	0