


THE PROCUREMENT OF WAREHOUSE EPOXY FLOOR WORK

ADDIS ABEBA ETHIOPIAN

UNOPS - ETMCO

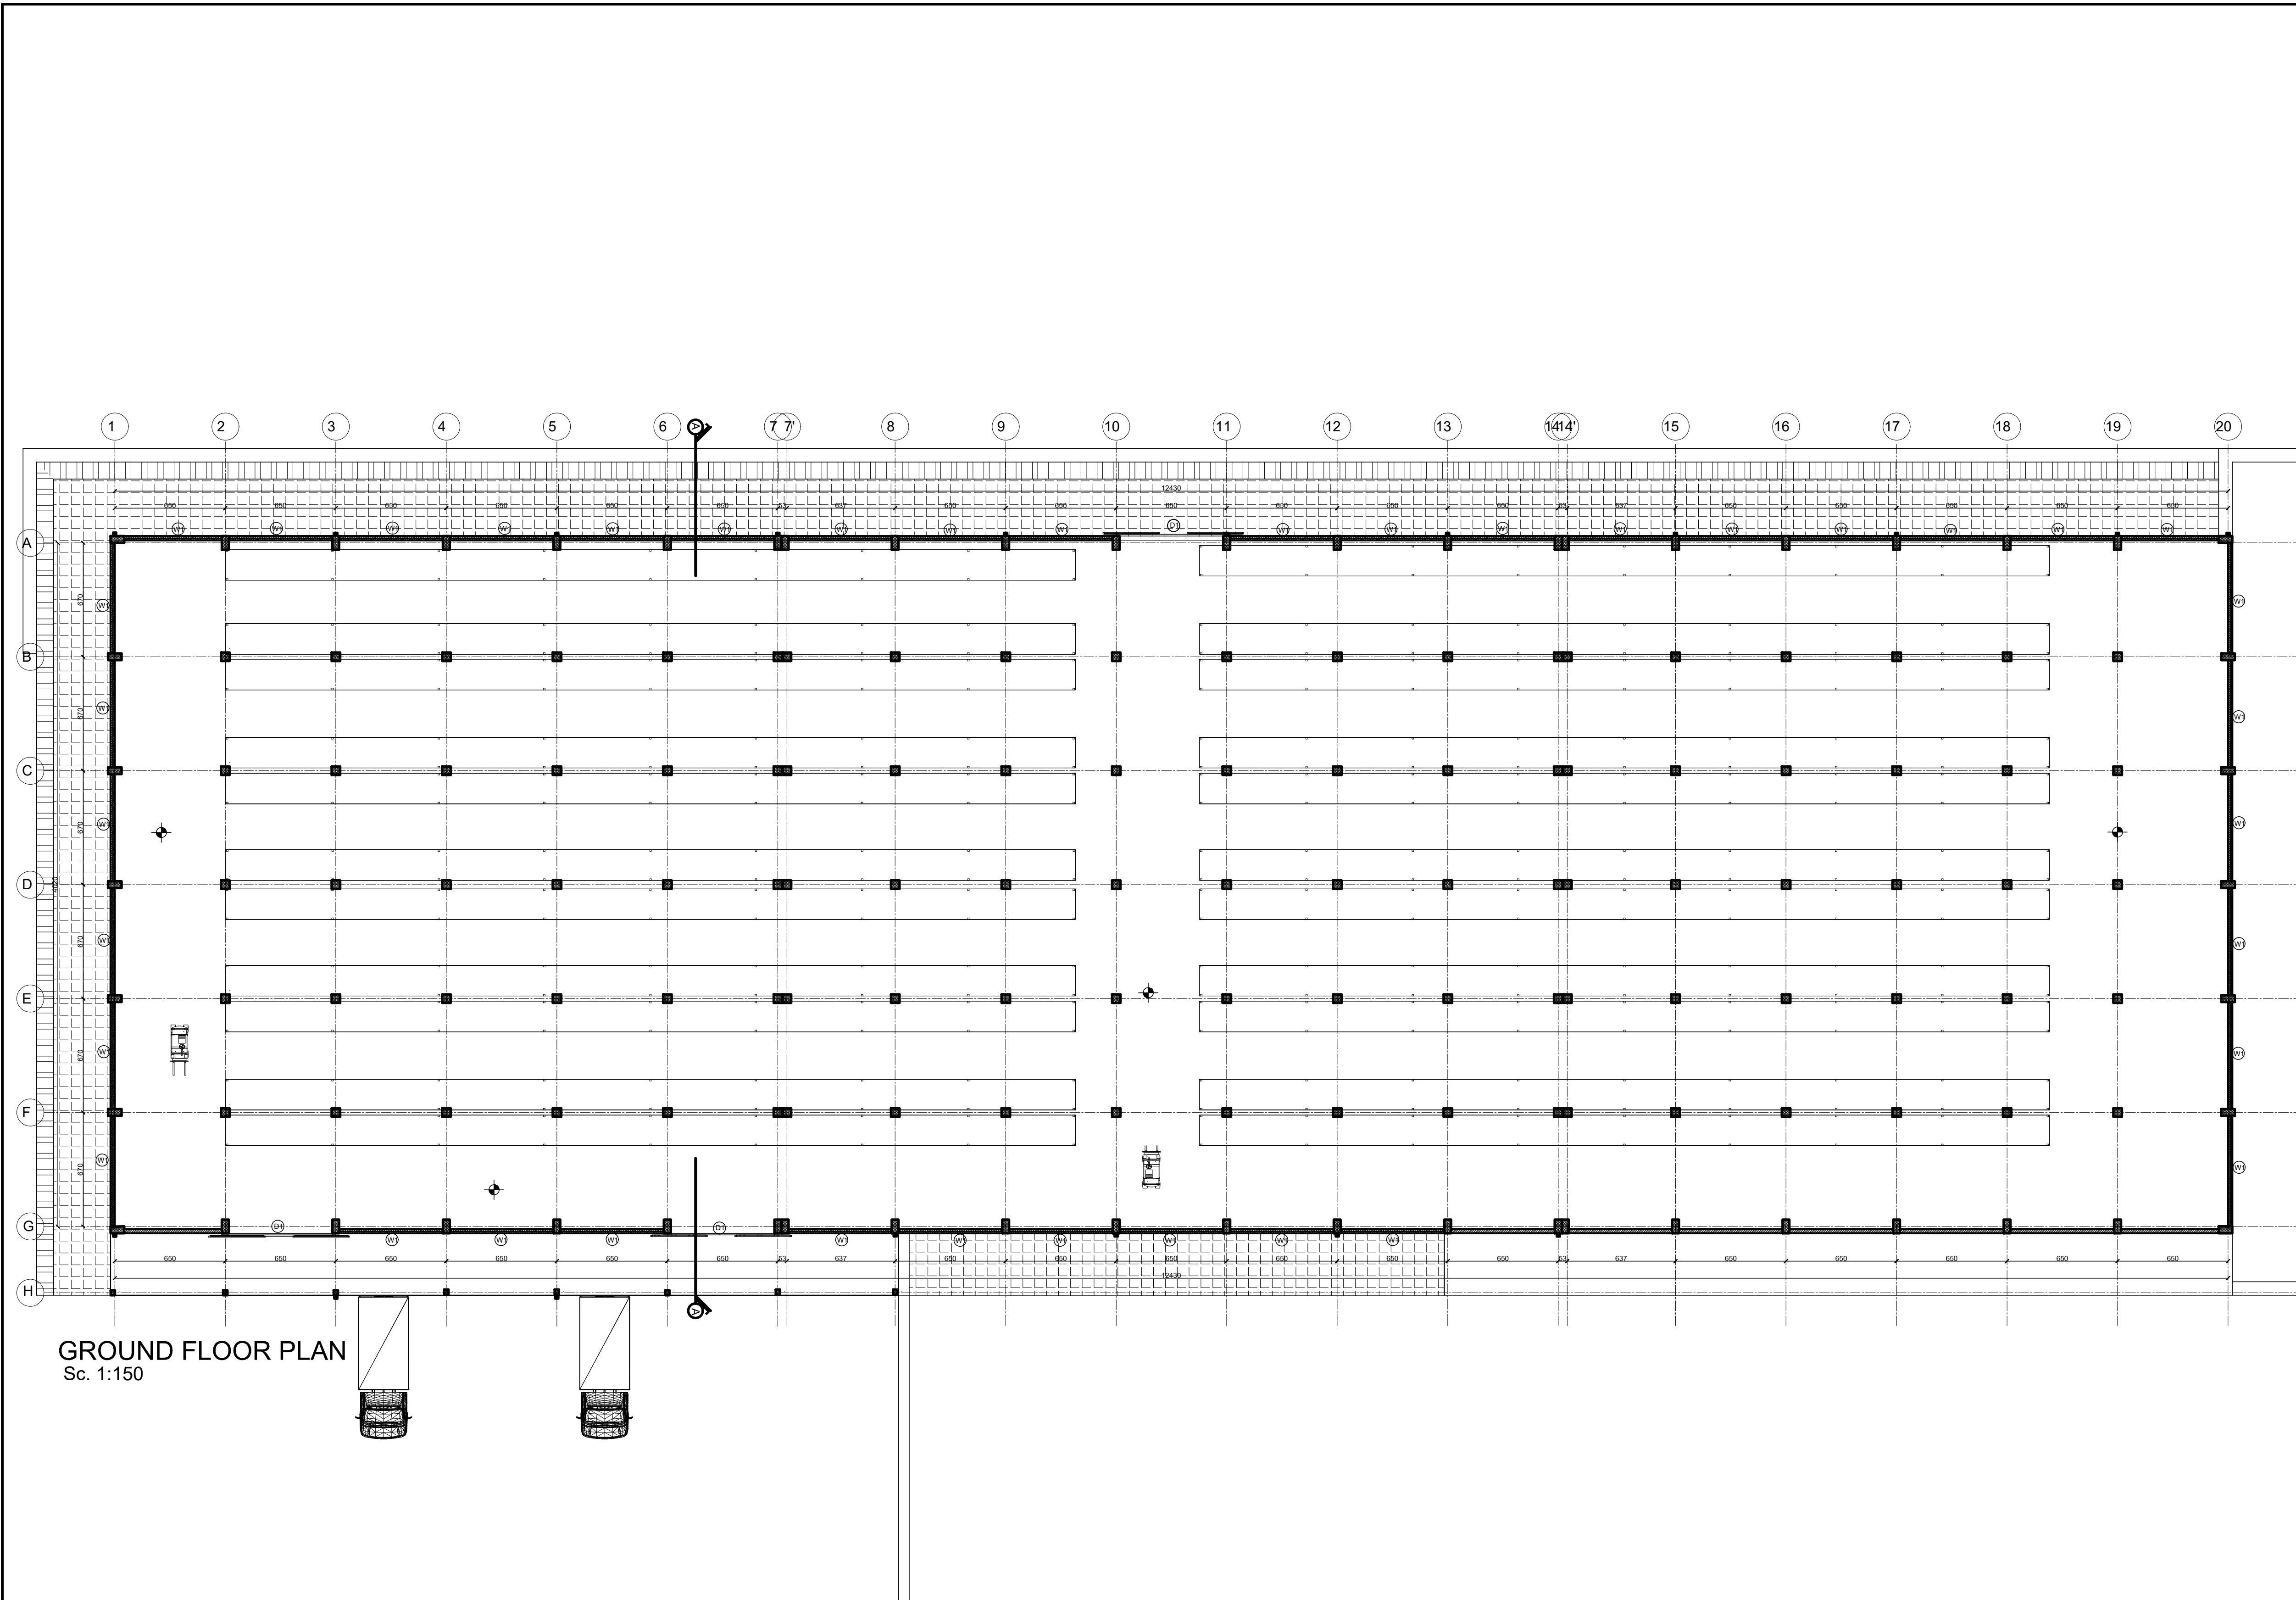


GROUND FLOOR PLAN
Sc. 1:150

GENERAL NOTES:

	/	/		
	/	/		
0	/	/		
Rev.:	Date:	Description:	Approved	

KEY PLAN				
All information in this document is the property of UNOPS and cannot be copied anywhere but in this project without prior written consent of UNOPS.				
Funded By:		Partner:		
		ETHIOPIAN PHARMACEUTICAL SUPPLY SERVICE (EPSS)		
Program:		Implemented By:		
THE PROCUREMENT OF WAREHOUSE FLOOR EPOXY WORK		UNOPS - ETMCO		
Project Name:		Design:		
WAREHOUSE FLOOR EPOXY WORK ADDIS ABEBA		UNOPS-ETMCO		
Drawing Title:				
GROUND FLOOR PLAN				
Designed by		Discipline:	Dr. No:	Tot. No:
		AR	01	06
As built				
Drawn:	Checked:	Approved:	Size:	Scale:
FM	AE	SH	A1	1:150
Date:		Rev.:		
6 / 25 / 2024		0		

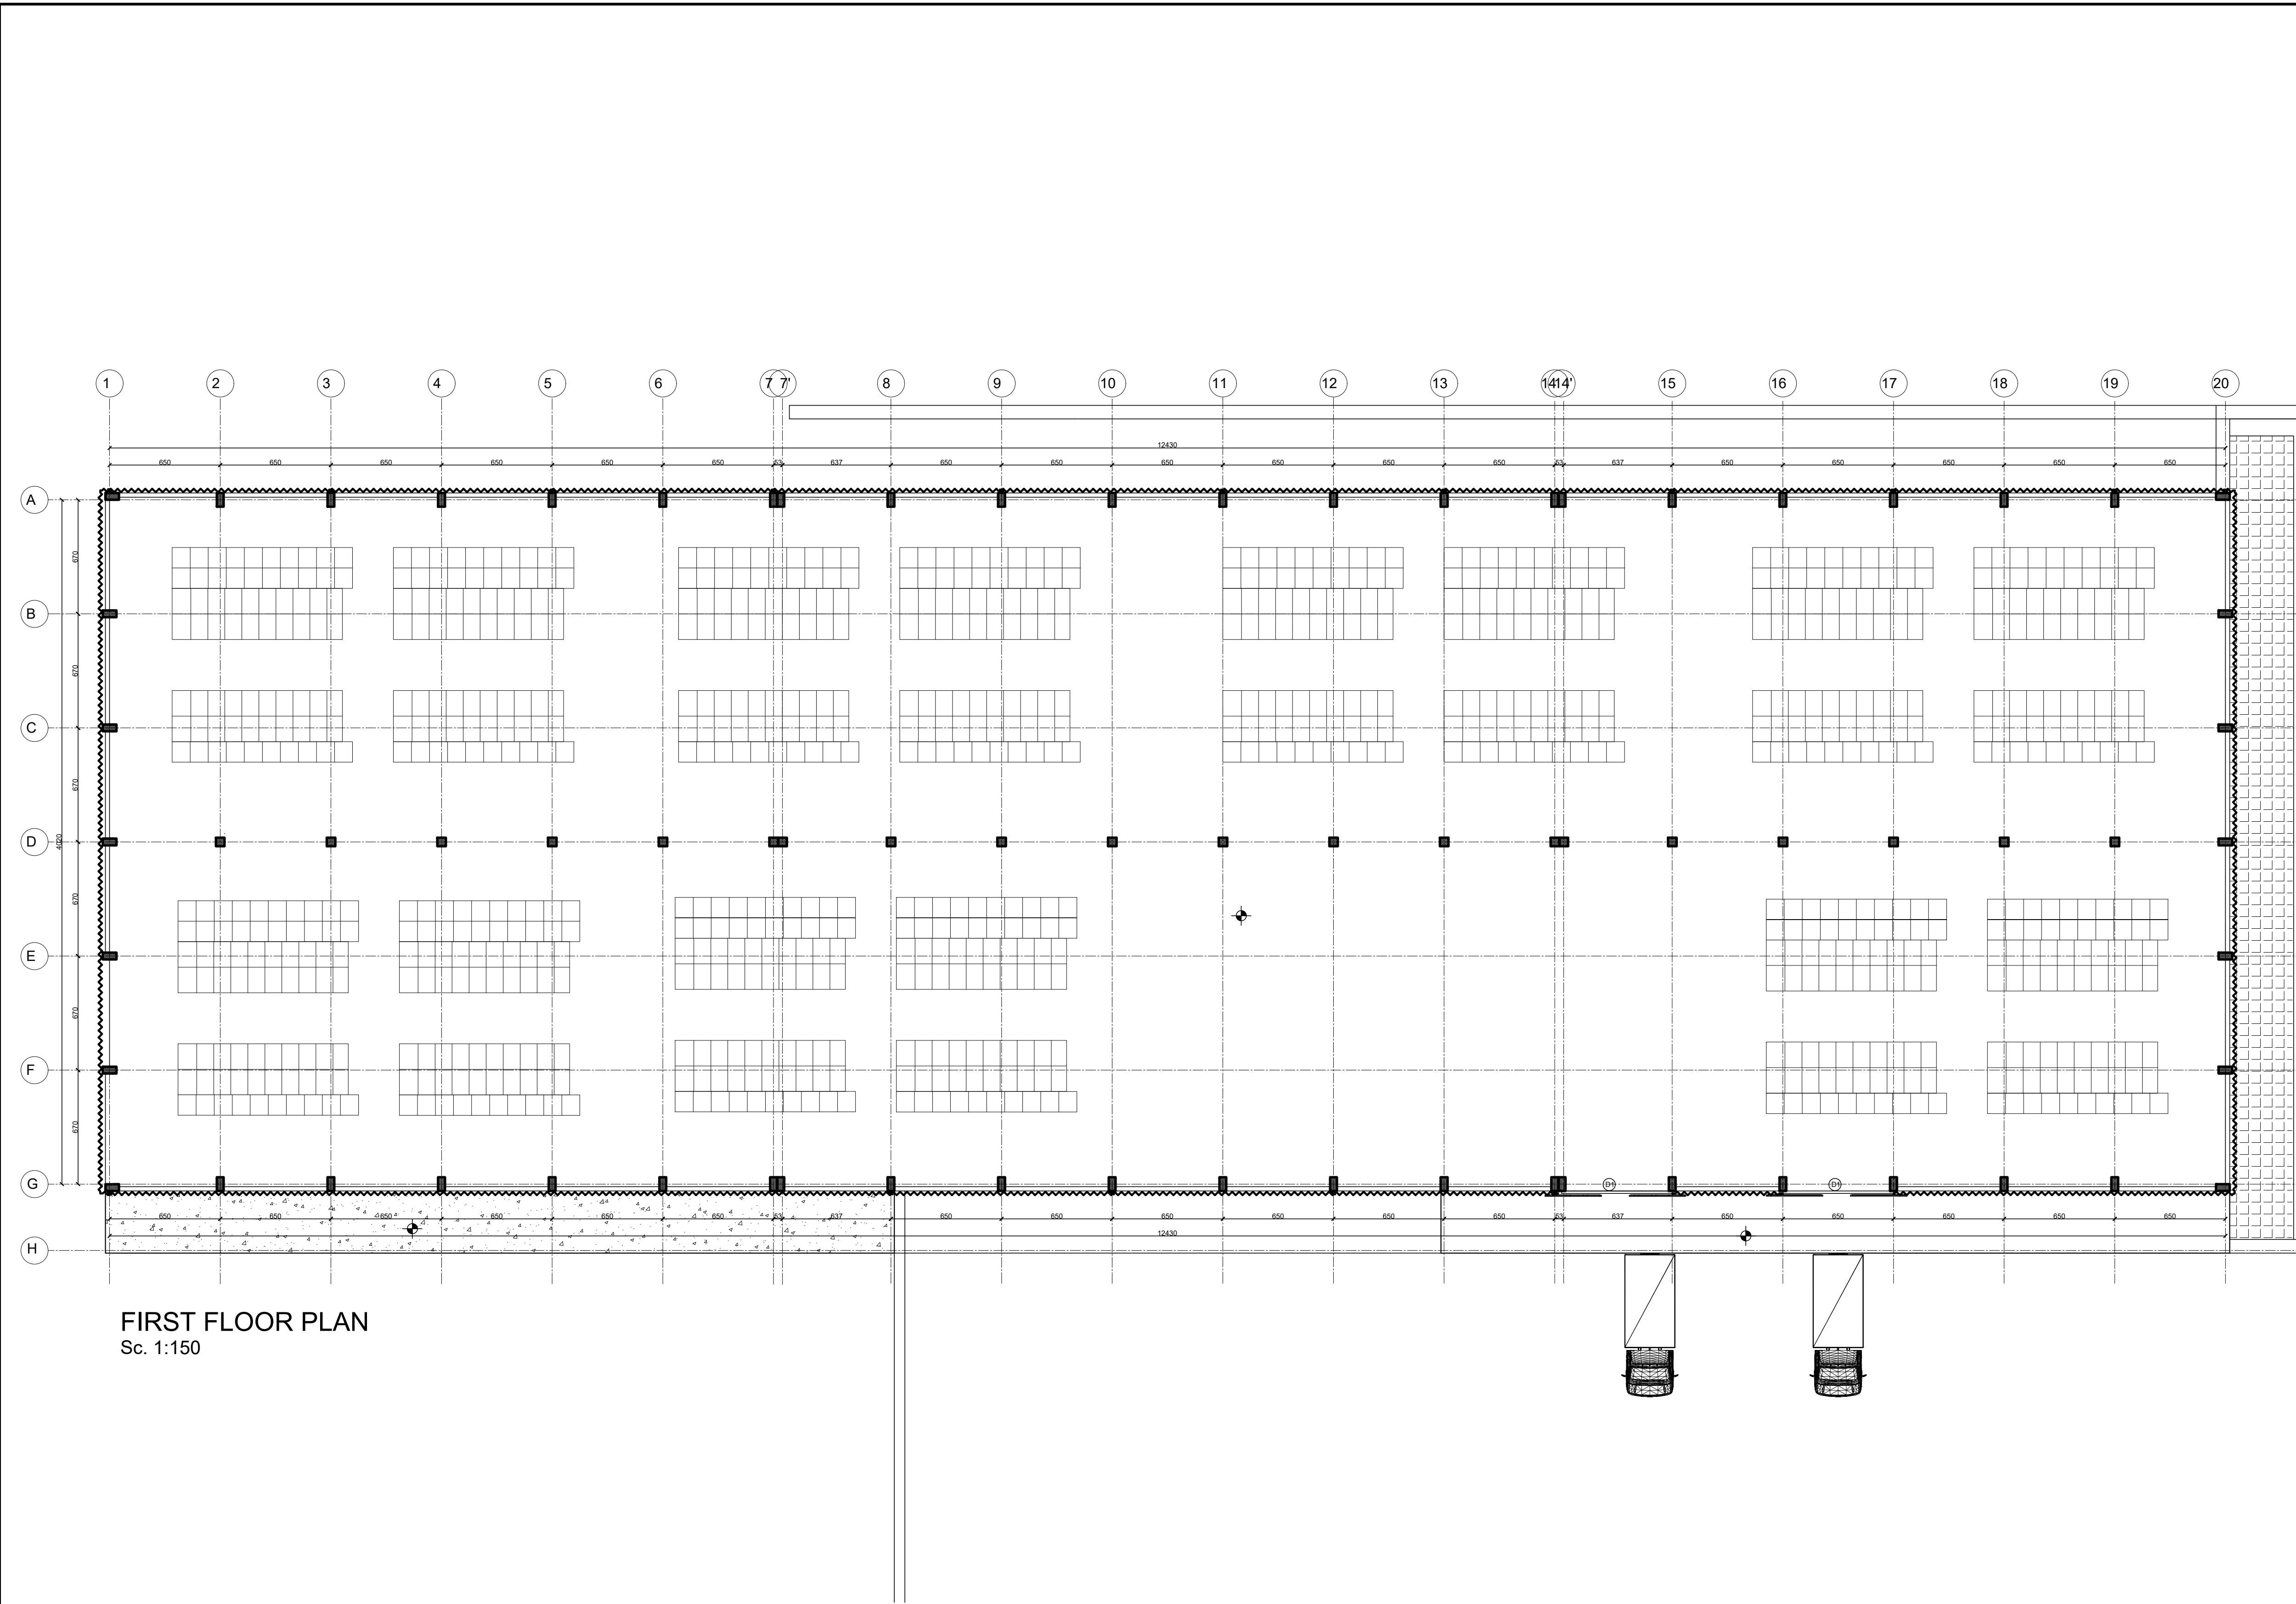


FIRST FLOOR PLAN
Sc. 1:150

- GENERAL NOTES:
- Note:
- 1) Roofing:-
- Replace damaged roof sheets and valley gutter.
 - Fix loose connections and joints.
 - Ensure no water leakage via roofing system.
 - Replace damaged down pipe and DP gypsum board cover and ensure proper connection vertically and with drainage line.
 - Ensure no water leakage via side retaining wall.
- 2) Interior & Exterior Walls:-
- Patch and repair defective plaster & repaint internal wall.
 - Patch and repair defective plaster & quartzes paint external wall.
 - Patch and repair damaged/defective plaster & repaint internal concrete column.
 - Fix metal angel iron protection to edge of internal exposed concrete columns.
- 3) Floor Finish:-
- Patch & repair construction joint and cement screed flooring.
 - Apply approved self leveling and epoxy floor coating above cement screed flooring.
 - Apply paint/skirting for HCB wall and concrete column.
 - Apply warehouse safety line/traffic painting on epoxy flooring.
 - Provide PWD access to the warehouse.
 - Provide proper water proof membrane and/or sub-surface drainage at one side of the warehouse adjacent to the the RW.

	/	/		
	/	/		
0	/	/		
Rev.:	Date:	Description:	Approved	

KEY PLAN					
All information in this document is the property of UNOPS and cannot be copied anywhere but in this project without prior written consent of UNOPS.					
Funded By:		Partner:			
		ETHIOPIAN PHARMACEUTICAL SUPPLY SERVICE (EPSS)			
Program:		Implemented By:			
THE PROCUREMENT OF WAREHOUSE FLOOR EPOXY WORK		UNOPS - ETMCO			
Project Name:		Design:			
WAREHOUSE FLOOR EPOXY WORK ADDIS ABEBA		UNOPS-ETMCO			
Drawing Title:					
FIRST FLOOR PLAN					
Designed by		Discipline:	Dr. No:	Tot. No:	Rev No:
		AR	02	06	As built
Drawn:	Checked:	Approved:	Size:	Scale:	Date:
FM	AE	SH	A1	1:150	6 / 25 / 2024
					Rev.:
					0

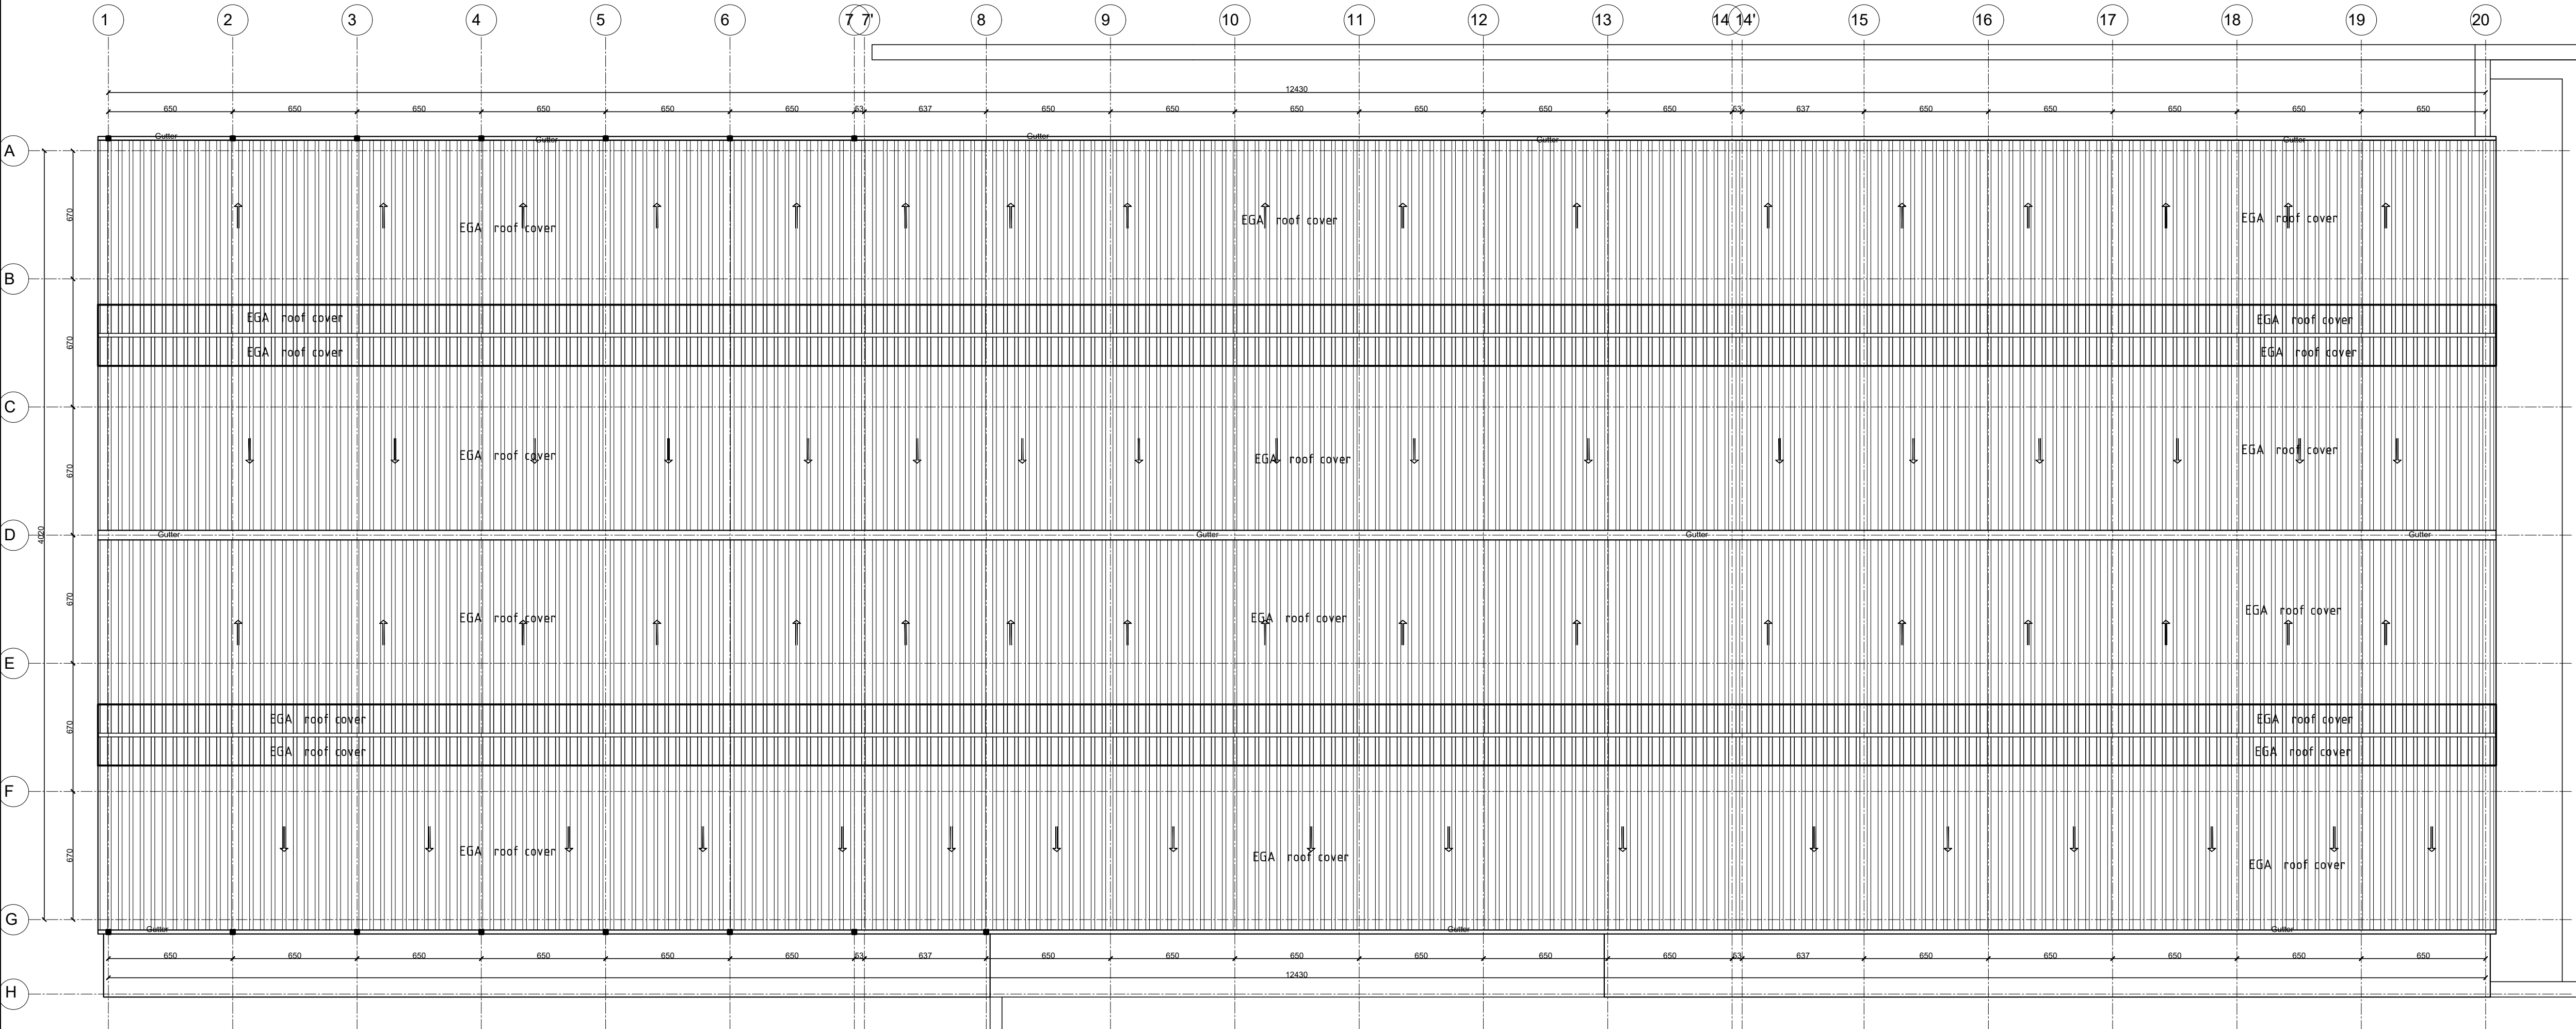


ROOF PLAN
Sc. 1:150

- GENERAL NOTES:
- Note:
- 1) Roofing:-
 - Replace damaged roof sheets and valley gutter.
 - Fix loose connections and joints.
 - Ensure no water leakage via roofing system.
 - Replace damaged down pipe and DP gypsum board cover and ensure proper connection vertically and with drainage line.
 - Ensure no water leakage via side retaining wall.
 - 2) Interior & Exterior Walls:-
 - Patch and repair defective plaster & repaint internal wall.
 - Patch and repair defective plaster & quartzes paint external wall.
 - Patch and repair damaged/defective plaster & repaint internal concrete column.
 - Fix metal angel iron protection to edge of internal exposed concrete columns.
 - 3) Floor Finish:-
 - Patch & repair construction joint and cement screed flooring.
 - Apply approved self leveling and epoxy floor coating above cement screed flooring.
 - Apply paint/skirting for HCB wall and concrete column.
 - Apply warehouse safety line/traffic painting on epoxy flooring.
 - Provide PWD access to the warehouse.
 - Provide proper water proof membrane and/or sub-surface drainage at one side of the warehouse adjacent to the the RW.

	/	/		
	/	/		
0	/	/		
Rev.:	Date:	Description:	Approved	

KEY PLAN				
information in this document is the property of UNOPS and cannot be copied anywhere but in this project without prior written consent of UNOPS.				
Funded By:		Partner:		
		ETHIOPIAN PHARMACEUTICAL SUPPLY SERVICE (EPSS)		
Program:		Implemented By:		
THE PROCUREMENT OF WAREHOUSE FLOOR EPOXY WORK		UNOPS - ETMCO		
Project Name:		Design:		
WAREHOUSE FLOOR EPOXY WORK ADDIS ABEBA		UNOPS-ETMCO		
Drawing Title:				

ROOF PLAN					
Designed by		Discipline:	Dr. No:	Tot. No:	Rev. No:
		AR	03	06	As built
Drawn:	Checked:	Approved:	Size:	Scale:	Date:
FM	AE	SH	A1	1:150	6 / 25 / 2024
				Rev.:	
				0	

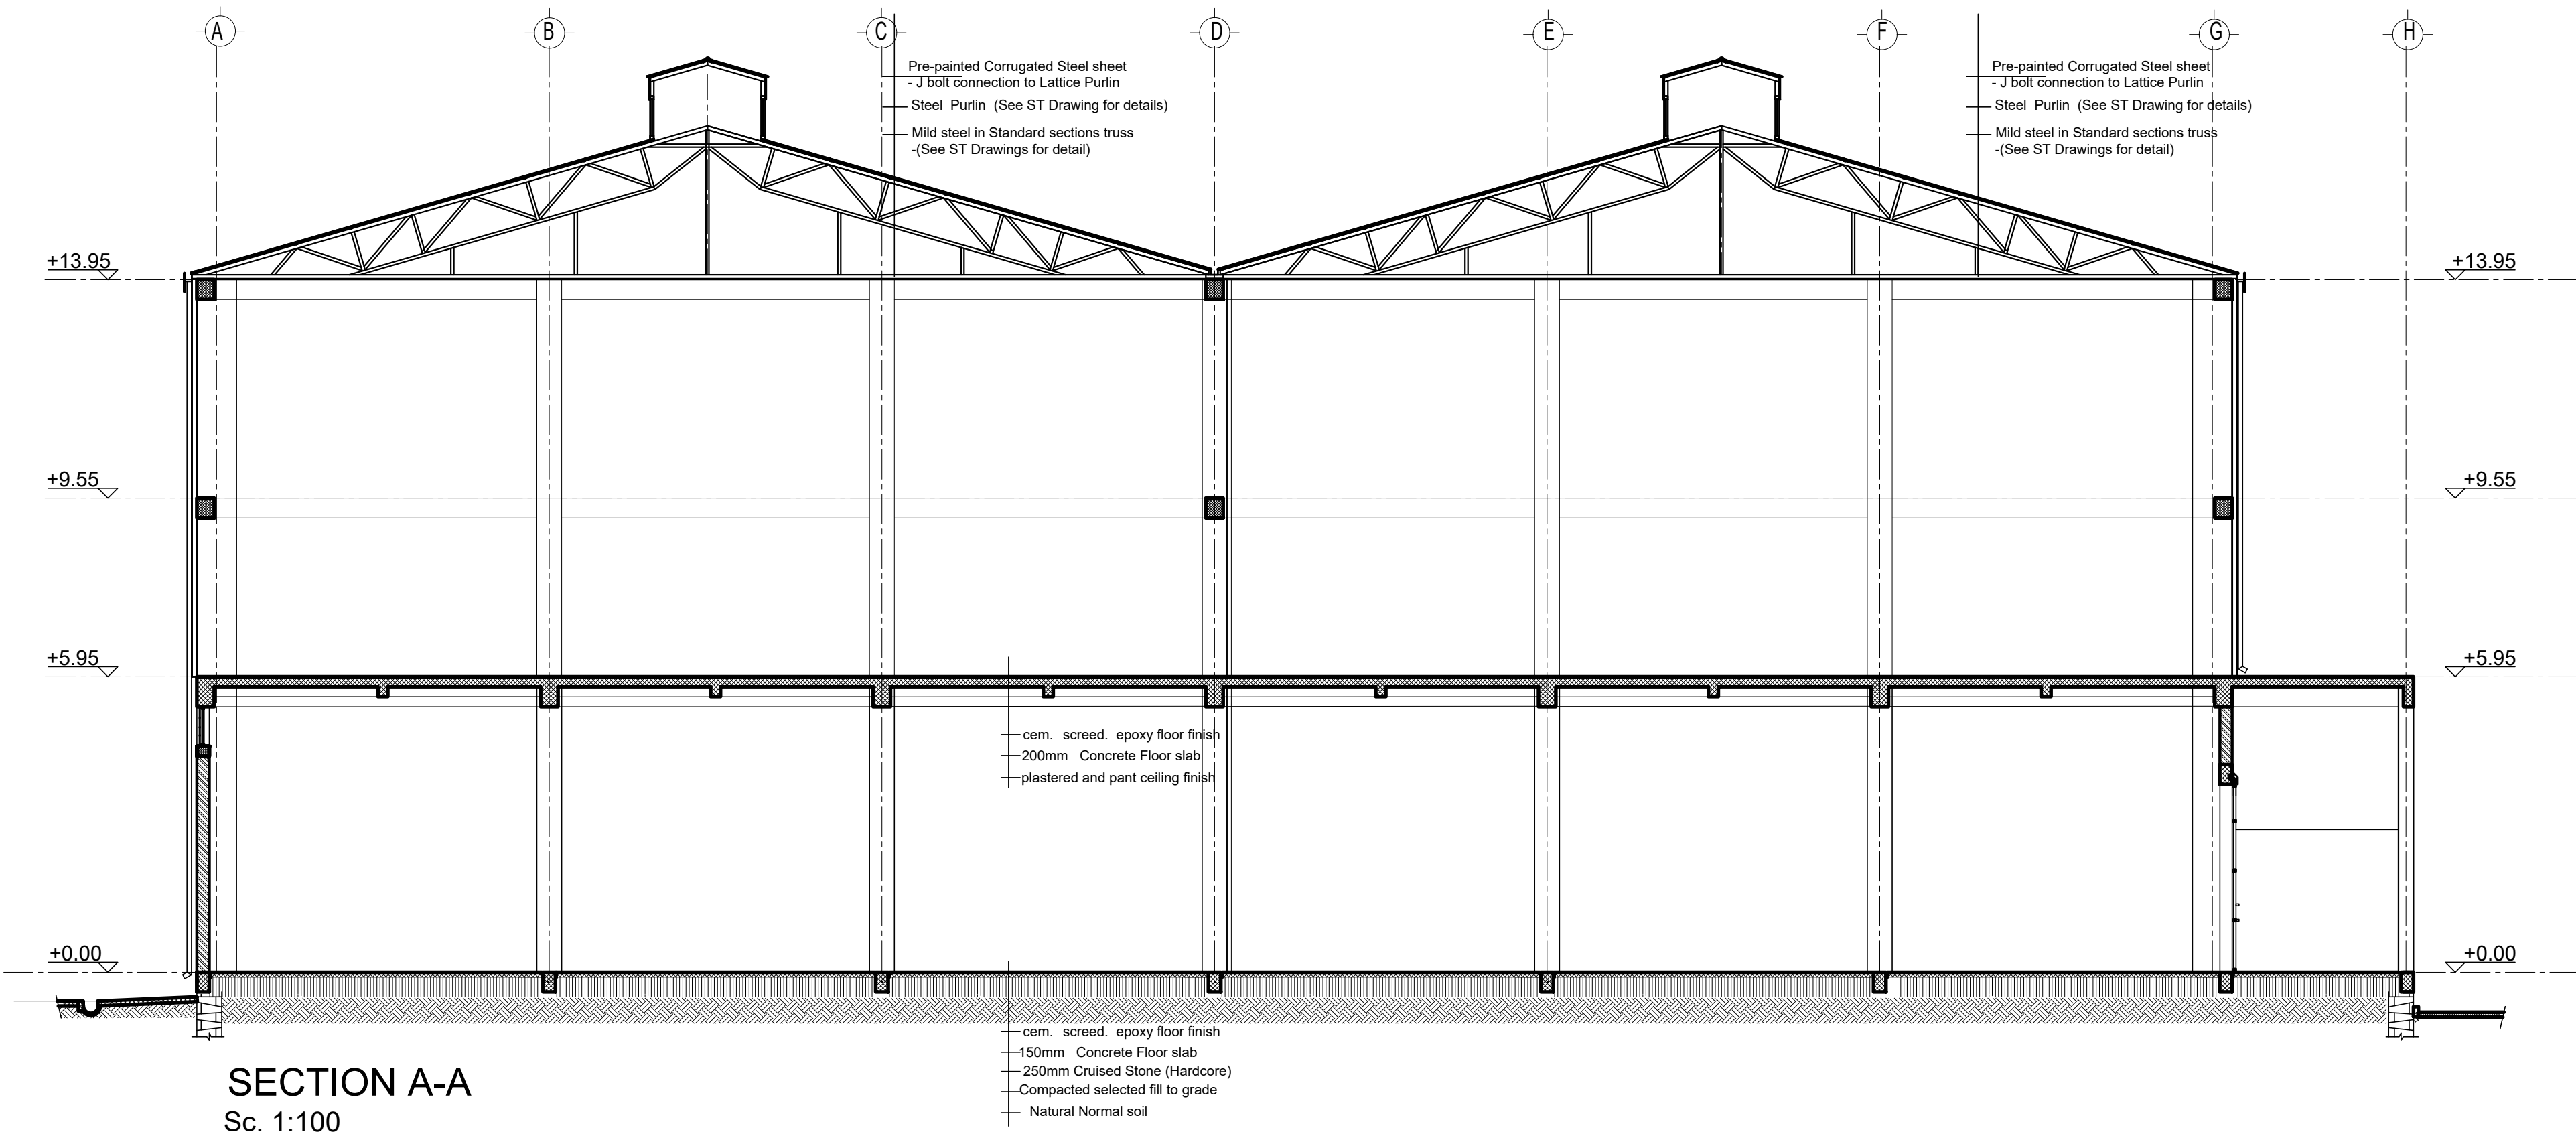

- GENERAL NOTES:
- Note:
- 1) Roofing:-
- Replace damaged roof sheets and valley gutter.
 - Fix loose connections and joints.
 - Ensure no water leakage via roofing system.
 - Replace damaged down pipe and DP gypsum board cover and ensure proper connection vertically and with drainage line.
 - Ensure no water leakage via side retaining wall.
- 2) Interior & Exterior Walls:-
- Patch and repair defective plaster & repaint internal wall.
 - Patch and repair defective plaster & quartzes paint external wall.
 - Patch and repair damaged/defective plaster & repaint internal concrete column.
 - Fix metal angel iron protection to edge of internal exposed concrete columns.
- 3) Floor Finish:-
- Patch & repair construction joint and cement screed flooring.
 - Apply approved self leveling and epoxy floor coating above cement screed flooring.
 - Apply paint/skirting for HCB wall and concrete column.
 - Apply warehouse safety line/traffic painting on epoxy flooring.
 - Provide PWD access to the warehouse.
 - Provide proper water proof membrane and/or sub-surface drainage at one side of the warehouse adjacent to the the RW.

	/	/		
	/	/		
0	/	/		
Rev.:	Date:	Description:	Approved	

KEY PLAN

All information in this document is the property of UNOPS and cannot be copied anywhere but in this project without prior written consent of UNOPS.

Funded By:

Partner:

ETHIOPIAN PHARMACEUTICAL
SUPPLY SERVICE (EPSS)

Program:

Implemented By:

UNOPS - ETMCO

Project Name:

Design:

UNOPS-ETMCO

WAREHOUSE FLOOR EPOXY WORK
ADDIS ABEBA

Drawing Title:

SECTION A-A

Designed by

Discipline:

Dr. No:

Tot. No:

Rev No:

AR

04

06

As built

Drawn:

Checked:

Approved:

Size:

Scale:

Date:

Rev.:

FM

AE


SH

A1


1:100

6 / 25 / 2024

0

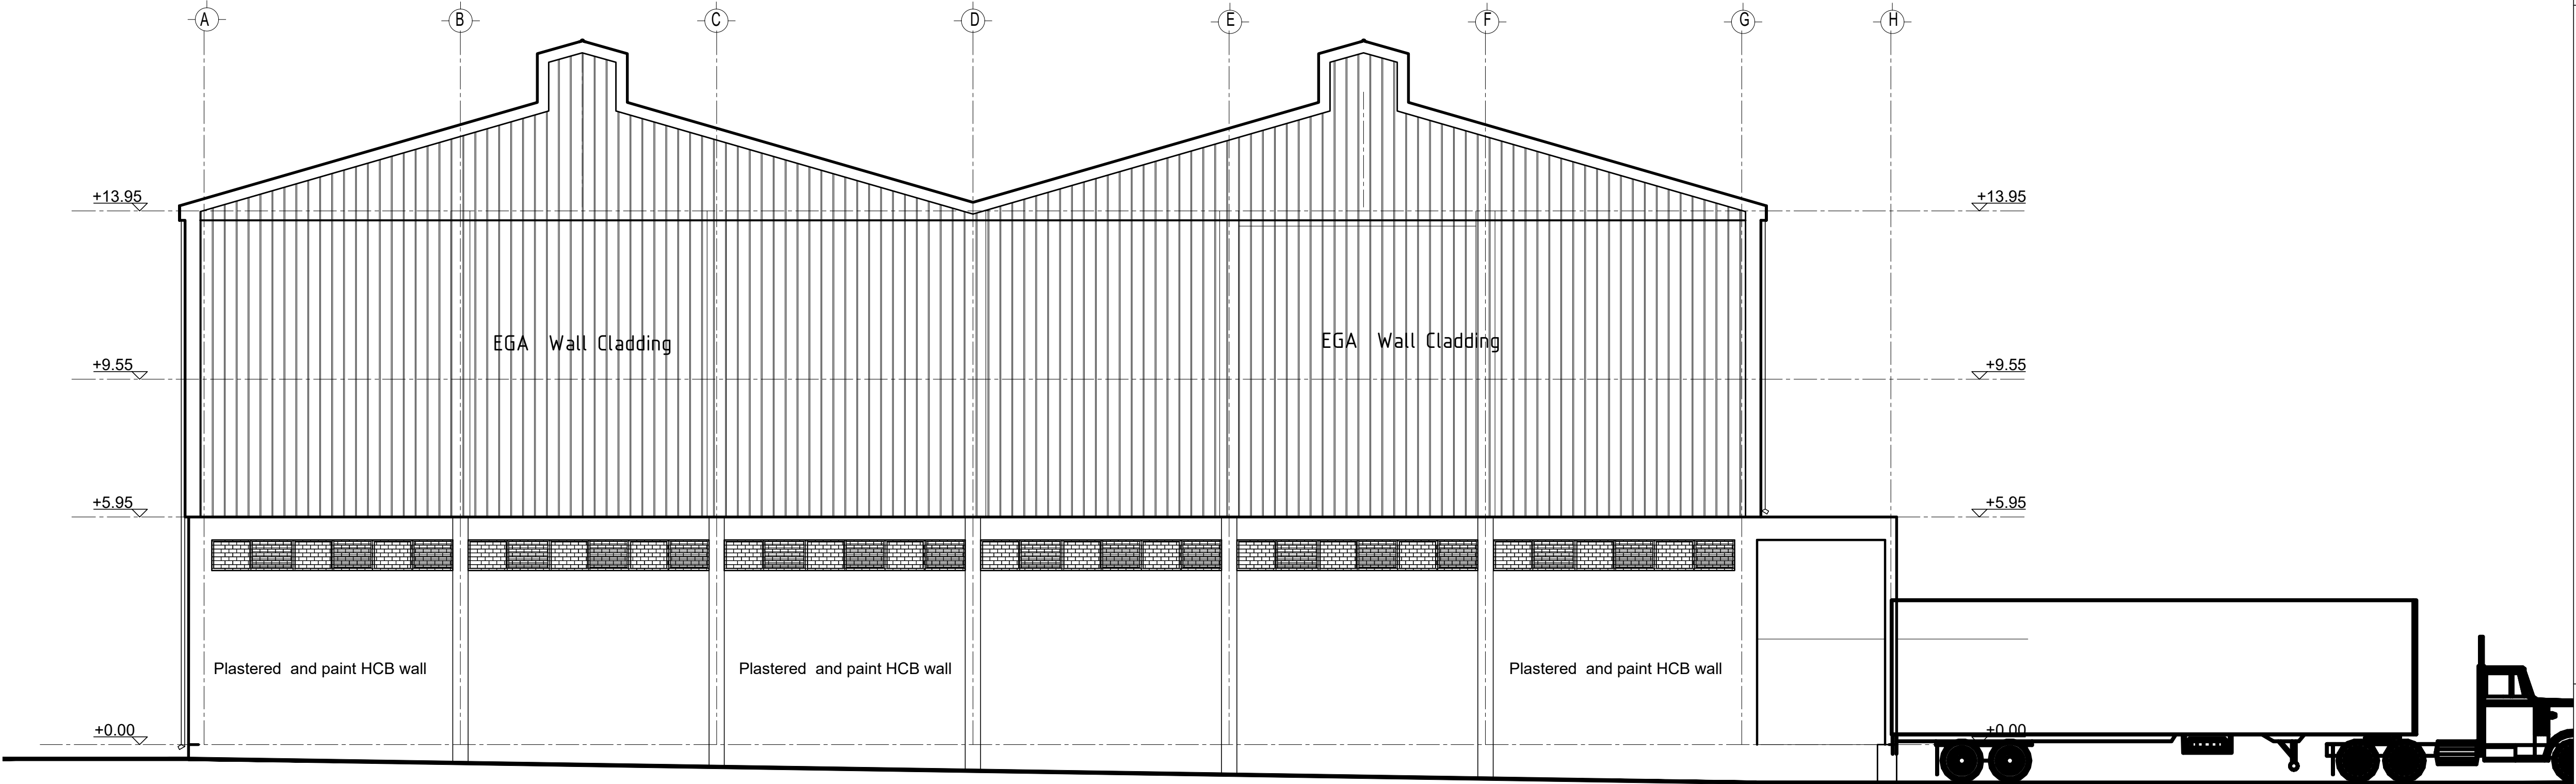

LEFT SIDE ELEVATION
Sc. 1:100

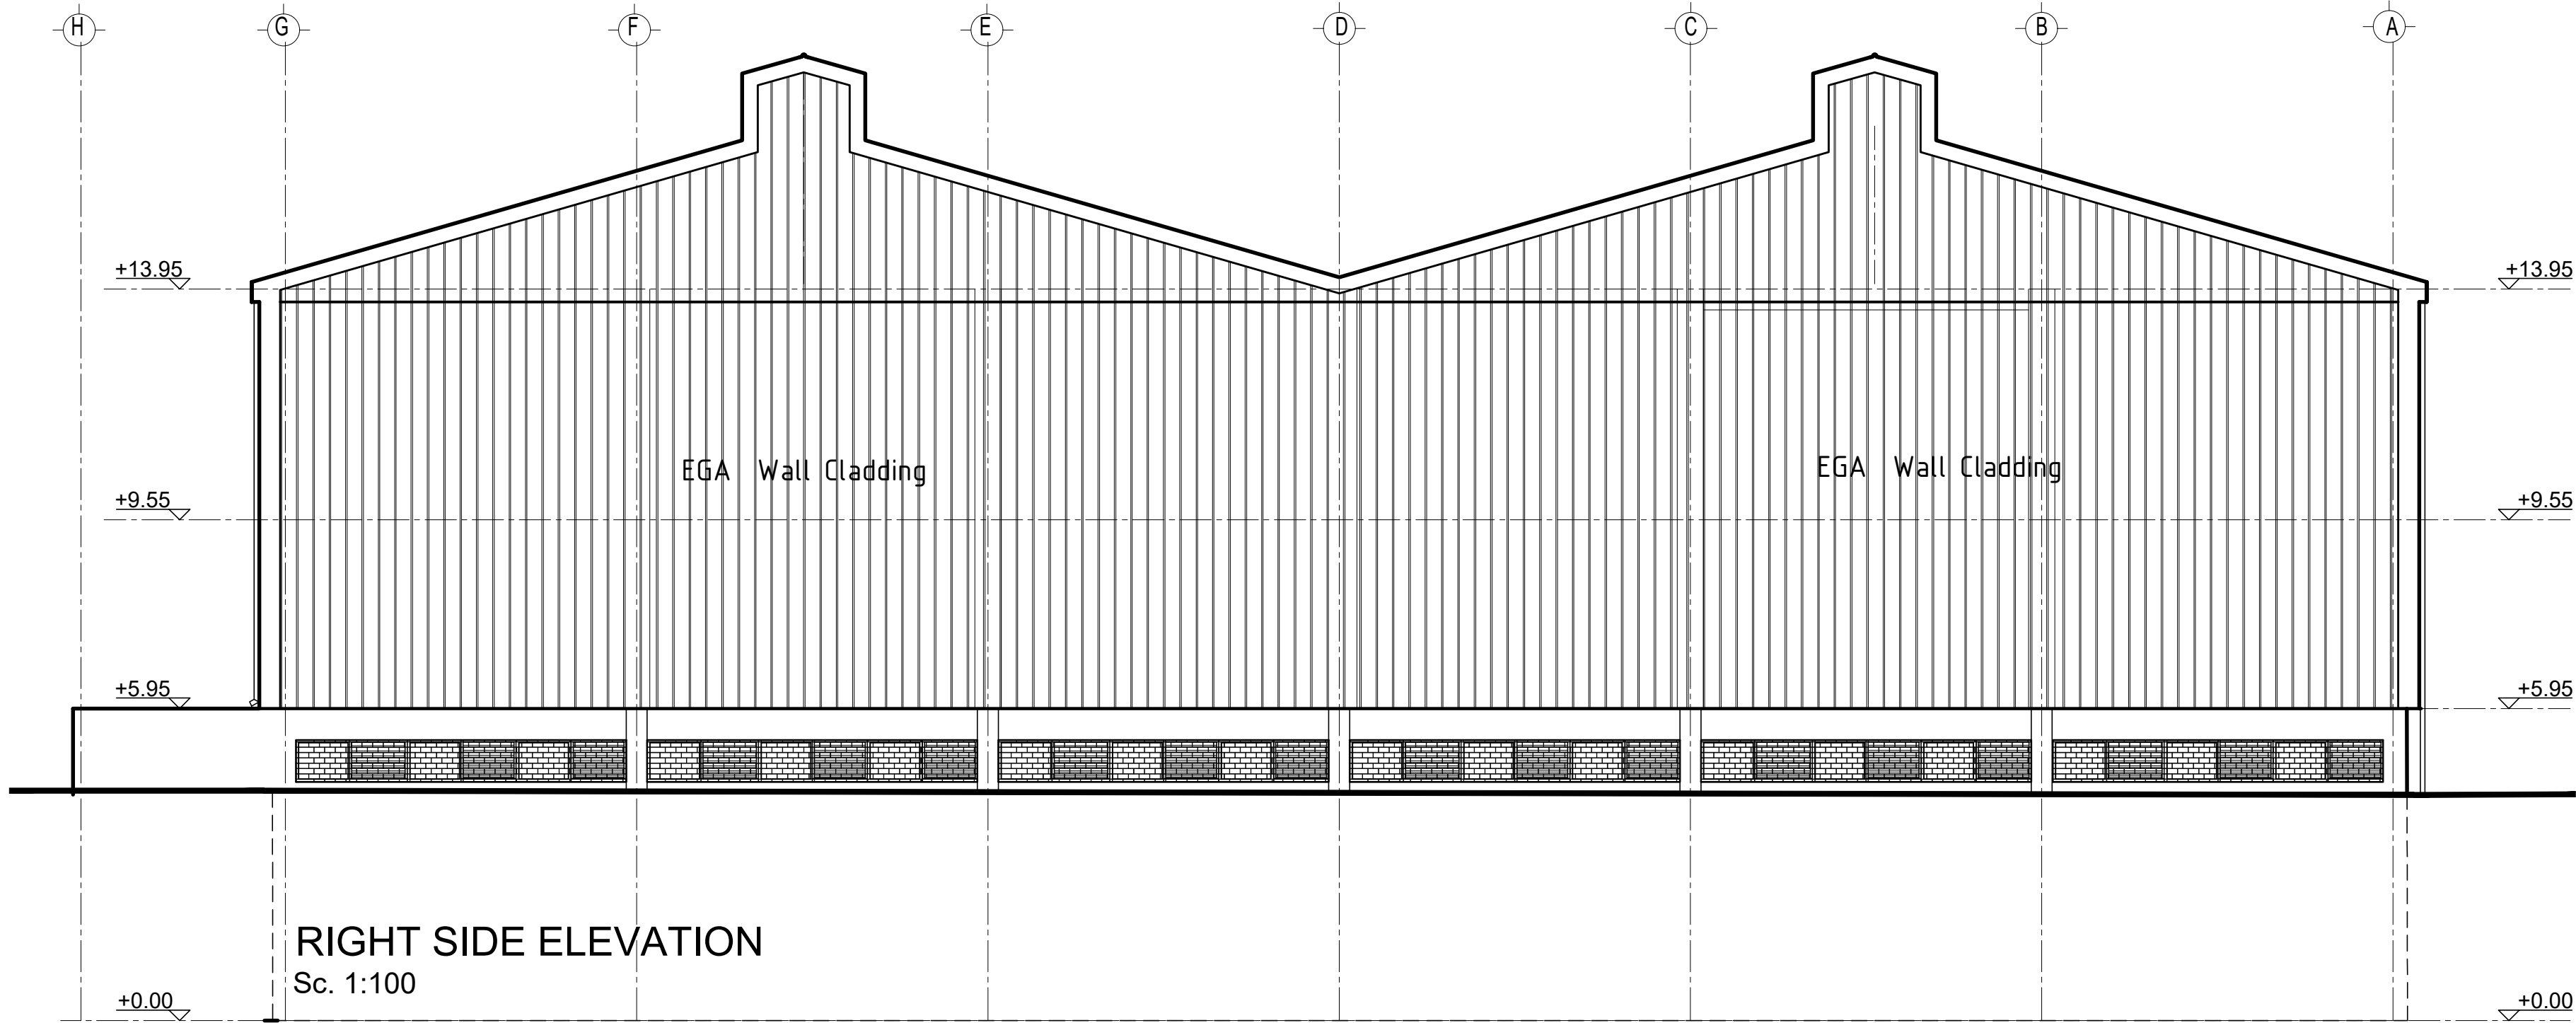


RIGHT SIDE ELEVATION
Sc. 1:100

- GENERAL NOTES:
- Note:
- 1) Roofing:-
 - Replace damaged roof sheets and valley gutter.
 - Fix loose connections and joints.
 - Ensure no water leakage via roofing system.
 - Replace damaged down pipe and DP gypsum board cover and ensure proper connection vertically and with drainage line.
 - Ensure no water leakage via side retaining wall.
 - 2) Interior & Exterior Walls:-
 - Patch and repair defective plaster & repaint internal wall.
 - Patch and repair defective plaster & quartzes paint external wall.
 - Patch and repair damaged/defective plaster & repaint internal concrete column.
 - Fix metal angel iron protection to edge of internal exposed concrete columns.
 - 3) Floor Finish:-
 - Patch & repair construction joint and cement screed flooring.
 - Apply approved self leveling and epoxy floor coating above cement screed flooring.
 - Apply paint/skirting for HCB wall and concrete column.
 - Apply warehouse safety line/traffic painting on epoxy flooring.
 - Provide PWD access to the warehouse.
 - Provide proper water proof membrane and/or sub-surface drainage at one side of the warehouse adjacent to the the RW.


	/	/		
	/	/		
0	/	/		
Rev.:	Date:	Description:	Approved	

KEY PLAN				
All information in this document is the property of UNOPS and cannot be copied anywhere but in this project without prior written consent of UNOPS.				
Funded By:		Partner:		
		ETHIOPIAN PHARMACEUTICAL SUPPLY SERVICE (EPSS)		
Program:		Implemented By:		
THE PROCUREMENT OF WAREHOUSE FLOOR EPOXY WORK		UNOPS - ETMCO		
Project Name:		Design:		
WAREHOUSE FLOOR EPOXY WORK ADDIS ABEBA		UNOPS-ETMCO		
Drawing Title:				

SIDE ELEVATION					
Designed by		Discipline:	Dr. No:	Tot. No:	Rev No:
		AR	05	06	As built
Drawn:	Checked:	Approved:	Size:	Scale:	Date:
FM	AE	SH	A1	1:100	6 / 25 / 2024
					Rev.:
					0

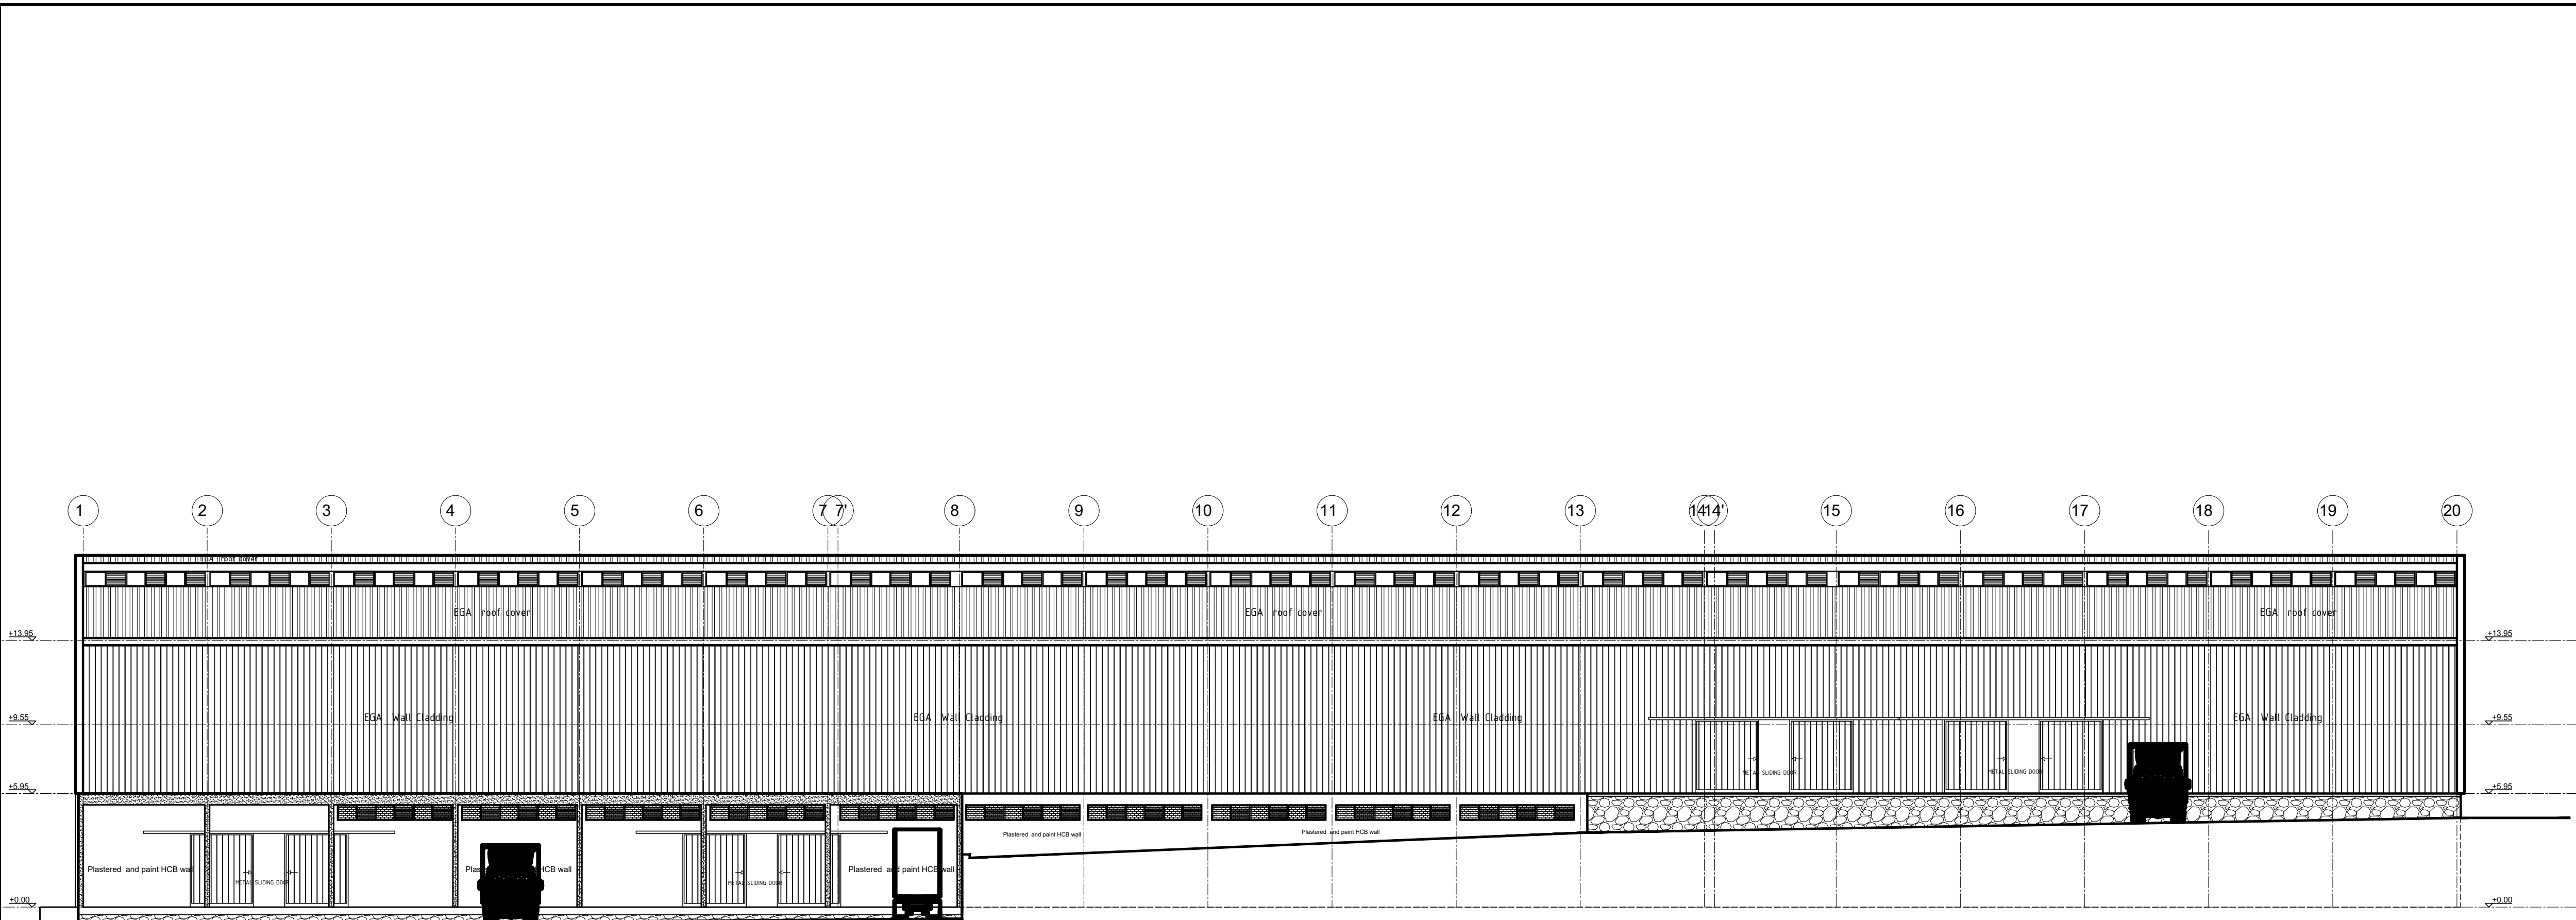

FRONT ELEVATION
Sc. 1:150

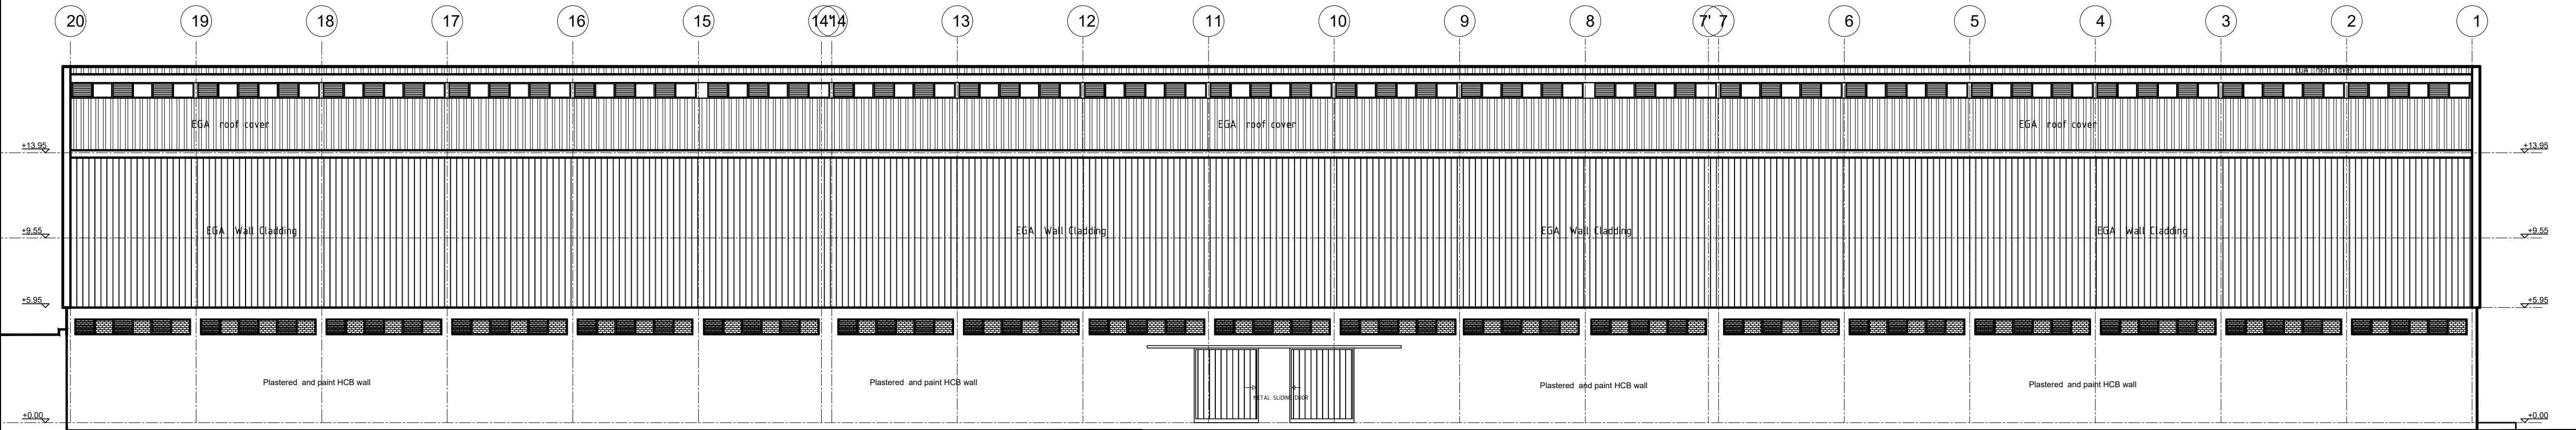

REAR ELEVATION
Sc. 1:150

GENERAL NOTES:

Note:

- 1) Roofing:-
- Replace damaged roof sheets and valley gutter.
 - Fix loose connections and joints.
 - Ensure no water leakage via roofing system.
 - Replace damaged down pipe and DP gypsum board cover and ensure proper connection vertically and with drainage line.
 - Ensure no water leakage via side retaining wall.
- 2) Interior & Exterior Walls:-
- Patch and repair defective plaster & repaint internal wall.
 - Patch and repair defective plaster & quartzes paint external wall.
 - Patch and repair damaged/defective plaster & repaint internal concrete column.
 - Fix metal angel iron protection to edge of internal exposed concrete columns.
- 3) Floor Finish:-
- Patch & repair construction joint and cement screed flooring.
 - Apply approved self leveling and epoxy floor coating above cement screed flooring.
 - Apply paint/skirting for HCB wall and concrete column.
 - Apply warehouse safety line/traffic painting on epoxy flooring.
 - Provide PWD access to the warehouse.
 - Provide proper water proof membrane and/or sub-surface drainage at one side of the warehouse adjacent to the the RW.

	/	/		
	/	/		
0	/	/		
Rev.:	Date:	Description:	Approved	

KEY PLAN

All information in this document is the property of UNOPS and cannot be copied anywhere but in this project without prior written consent of UNOPS.	
Funded By:	Partner:
	ETHIOPIAN PHARMACEUTICAL SUPPLY SERVICE (EPSS)
Program:	Implemented By:
THE PROCUREMENT OF WAREHOUSE FLOOR EPOXY WORK	UNOPS - ETMCO
Project Name:	Design:
WAREHOUSE FLOOR EPOXY WORK ADDIS ABEBA	UNOPS-ETMCO
Drawing Title:	

ELEVATION

Designed by			Discipline:	Dr. No:	Tot. No:	Rev No:
			AR	06	06	As built
Drawn:	Checked:	Approved:	Size:	Scale:	Date:	Rev.:
FM	AE	SH	A1	1:150	6 / 25 / 2024	0